

JASPER

WATER WELL DRILLERS LOG

Date: 5-25-62 1962 Driller: U. L. Welch County Jasper

(1) Owner of Land: C. M. Knowles  
(Name)  
Harlandville Miss  
(Address)

Description & Color of Materials  
Sand, Clay, Red Clay, Shell, etc.

Thick-  
ness  
Feet

Depth  
Feet

Clay 12 0-12  
Sand 78 12-90

(2) Location: NW 1/4, NW 1/4, Sec. 12 T4R 11  
10 miles South of Monte  
(distance) (direction) (Nearest Town)

(3) Topography:  (Hilly)  (Flat)  (Level)

(4) Purpose of Well: Domestic  
(Domestic Irrigation  
Municipal, Industrial, Other)

Information upon completion of well:

(1) Diameter: 3 1/2 inches.

(2) Total Depth: 90 feet.

(3) Water Level: 18 feet below top of ground.

(4) Cased to: 90, Size 2"


(5) Screen: Size 70ths, Length 10'

(6) Were any formations sealed against pollution?  
no

If YES depth of formation \_\_\_\_\_

Why \_\_\_\_\_

Drillers Remarks: \_\_\_\_\_

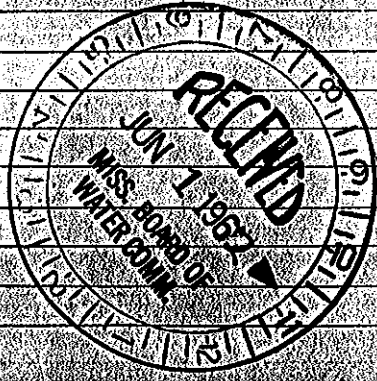

(Use Back Side)

Well No. 35

Retain this copy for your office files.