

JASPER

MISSISSIPPI BOARD OF WATER COMMISSIONERS

4-20-63

WATER WELL DRILLERS LOG

Date 4-20, 1963, Driller: U. D. Shedd County Jasper
(Name)

(1) Owner of Land: Mei Church
(Name)
Garlandville Miss
(Address)

(2) Location: NW 1/4 NE 1/4, Sec. 1 T5R11
10 miles S, of Ant
(distance) (direction) (Nearest Town)

(3) Topography: (Hilly) (Flat) (Level)

(4) Purpose of Well: Choral
(Domestic Irrigation
Municipal, Industrial, Other)

Description & Color of Materials Sand, Clay, Red Clay, Shell, etc.	Thick- ness Feet	Depth Feet
<u>K clay</u>	<u>22</u>	<u>0-22</u>
<u>G-2</u>	<u>53</u>	<u>22-75</u>


Information upon completion of well:

- (1) Diameter 2 inches.
- (2) Total Depth 73 feet.
- (3) Water Level 38 feet below top of ground.
- (4) Cased to 73, Size 24.
- (5) Screen: Size 80%, Length 10'.
- (6) Were any formations sealed against pollution?
_____ yes, _____ no.

If YES depth of formation _____

Why _____

Drillers Remarks: _____

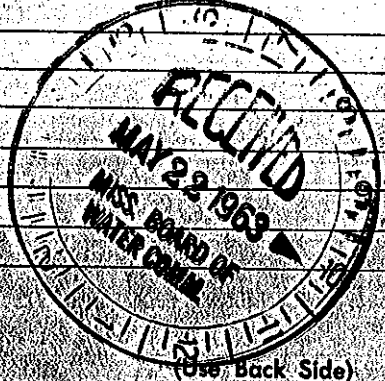

(Use Back Side)

Well No. 100

Retain this copy for your office files