

JASPER MISSISSIPPI BOARD OF WATER COMMISSIONERS

WATER WELL DRILLERS LOG

B7
5-28-64

Date: 5-28, 1964, Driller: U. L. Shelch County Jasper

(1) Owner of Land: R. A. Keith Sr.
(Name)
Newton Smiss
(Address)

(2) Location: NW 1/4, SW 1/4, Sec. 1 T. 5 R. 11.
8 miles S of Newton
(distance) (direction) (Nearest Town)

(3) Topography: (Hilly) (Flat) (Level)

(4) Purpose of Well: Domestic
(Domestic Irrigation, Municipal, Industrial, Other)

Description & Color of Materials Sand, Clay, Red Clay, Shell, etc.	Thick- ness Feet	Depth Feet
Yellow Clay	220-222	
R Sand	222-224	2
Brown	224-264	
B Sand	1064-74	
G Sand	6774-141	

Information upon completion of well:

(1) Diameter 2" inches.

(2) Total Depth 141 feet.

(3) Water Level 38 feet below top of ground.

(4) Cased to 141, Size 2"


(5) Screen: Size 8 slt Length 11'

(6) Were any formations sealed against pollution?
yes, no.

If YES depth of formation _____

Why _____

Drillers Remarks: _____

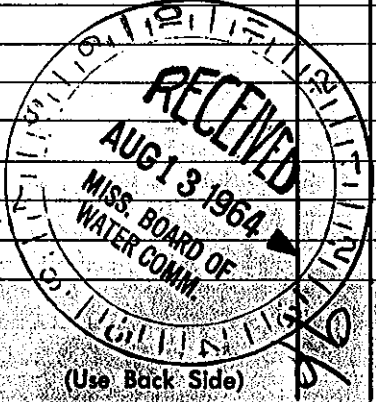

Well No. _____

(Use Back Side)

all this copy to Board of Water Commissioners 429 Miss. St. Jackson, Miss.