

**JASPER MISSISSIPPI BOARD OF WATER COMMISSIONERS**

**WATER WELL DRILLERS LOG**

Date: 9-13, 1963, Driller: U. L. Helch County Jasper  
(Name)

(1) Owner of Land: W. H. Estes  
(Name)  
Newton Miss  
(Address)

(2) Location: SE 1/4, NW 1/4, Sec. 2 T4 R12  
9 miles S, of Hickory  
(distance) (direction) (Nearest Town)

(3) Topography:  (Hilly)  (Flat)  (Level)

(4) Purpose of Well: Domestic  
(Domestic Irrigation Municipal, Industrial, Other)

Description & Color of Materials Sand, Clay, Red Clay, Shell, etc.	Thick- ness Feet	Depth Feet
Clay	16	0-16
Blue	100	16-116
Brown & sandy	32	116-159
Sandy	73	159-191
Sand		

264

Information upon completion of well:

(1) Diameter: 3 1/2 inches.

(2) Total Depth: 262 feet.


(3) Water Level: 77 feet below top of ground.

(4) Cased to: 262, Size 2"

(5) Screen: Size 2", Length 10'

(6) Were any formations sealed against pollution?  
 yes,  no,

If YES depth of formation \_\_\_\_\_  
 Why \_\_\_\_\_  
 Drillers Remarks: \_\_\_\_\_

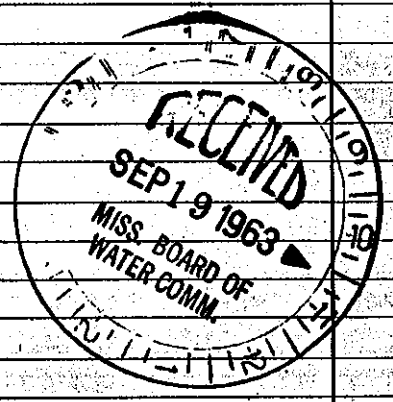

Well No  
76

(Use Back Side)

all this copy to Board of Water Commissioners 429 Miss. St. Jackson, Mis.