

JASPER

MISSISSIPPI BOARD OF WATER COMMISSIONERS

3 C3

Sched.

3

P

8-16-65 WATER WELL DRILLERS LOG

Date: 8-16, 1965, Driller: BROWN BROTHERS County JASPER

(Name)

(1) Owner of Land: W.H. Harris
(Name)
NEWTON MISS
(Address)

(2) Location: 1/4, 1/4, Sec. 3 T4R12
8 miles South, of NEWTON
(distance) (direction) (Nearest Town)

(3) Topography: Hilly
(Hilly) (Flat) (Level)

(4) Purpose of Well: Home
(Domestic Irrigation, Municipal, Industrial, Other)

Description & Color of Materials Sand, Clay, Red Clay, Shell, etc.	Thick- ness Feet	Depth Feet
Clay Sand	0	20
Green Shale	20	40
" "	40	60
" "	60	80
" "	80	100
Shale with	100	20
" "	20	40
Light	40	60
Sand at 158ft	60	80
Gray shale	80	200
" "	200	20
Sand at 218ft	20	40
" "	40	60


Information upon completion of well:

- (1) Diameter 4 1/2 inches.
- (2) Total Depth 240 feet.
- (3) Water Level 76 feet below top of ground.
- (4) Cased to 230, Size 2 in
- (5) Screen: Size 2, Length 10
- (6) Were any formations sealed against pollution?
no yes, no no.

If YES depth of formation _____

Why _____

Drillers Remarks: _____

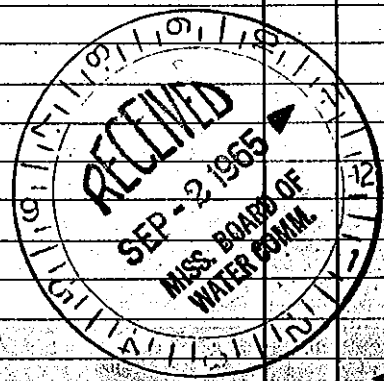

Well No. 5

(Use Back Side)