

JASPER

MISSISSIPPI BOARD OF WATER COMMISSIONERS

3 C4

Sched.

8-17-65

WATER WELL DRILLERS LOG 4

Date: 8-17, 1965, Driller: BROWN BROTHERS County: JASPER

(Name)

(1) Owner of Land: C. E. Williams
(Name)
NEWTON MISS
(Address)

(2) Location: 1/4, 1/4, Sec. 3 T4R12
7 1/2 miles S, E of NEWTON
(distance) (direction) (Nearest Town)

(3) Topography: Hilly
(Hilly) (Flat) (Level)


(4) Purpose of Well: HOME
(Domestic Irrigation
Municipal, Industrial, Other)

Description & Color of Materials Sand, Clay, Red Clay, Shell, etc.	Thick- ness Feet	Depth Feet
CLAY SAND	0	70
SHALE	20	40
	40	60
	60	80
	80	100
High nit	100	20
Brown shale	80	40
SAND AT 140	40	60

Information upon completion of well:

- (1) Diameter 4 1/2 inches.
- (2) Total Depth 157 feet.
- (3) Water Level 73 FT feet below top of ground.
- (4) Cased to 147, Size 2 in.
- (5) Screen: Size 2 in. x 8, Length 10.
- (6) Were any formations sealed against pollution?
yes, NO no.

If YES depth of formation
Why
Drillers Remarks:

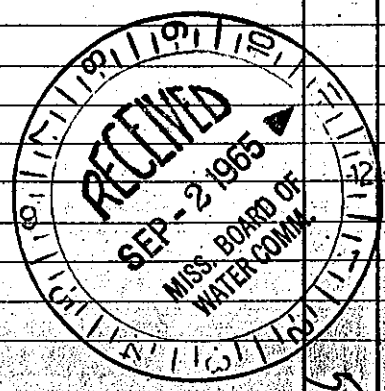

(Use Back Side)

Well No

Mail this copy to Board of Water Commissioners 429 Miss. St. Jackson, Miss