

JASPER
8-26-60

WATER WELL DRILLERS LOG

2300
Jasper

Date: 8/26/60 1960, Driller: L. K. Merritt County Jasper
(Name)


(1) Owner of Land: Dan Jay
(Name)
Rose Hill, Miss
(Address)
(2) Location: 1/4, 1/4, Sec. 14 AN 12E
T R
10 miles South of Hickory
(distance) (direction) (Nearest Town)
(3) Topography: (Hilly) (Flat) (Level)
(4) Purpose of Well: Domestic
(Domestic Irrigation, Municipal, Industrial, Other)

Description & Color of Materials Sand, Clay, Red Clay, Shell, etc.	Thick- ness Feet	Depth Feet
0-12		
<u>purple clay sand</u>	<u>0</u>	<u>12</u>
<u>Red clay fine sand</u>	<u>12</u>	<u>20</u>
<u>White clay + fine sand</u>	<u>20</u>	<u>82</u>
<u>Fine shell cut with clay</u>	<u>82</u>	<u>100</u>
<u>Med. fine grey sand</u>	<u>100</u>	<u>133</u>
<u>Blue clay + sand</u>	<u>133</u>	<u>140</u>

Information upon completion of well:

(1) Diameter 2 inches.
(2) Total Depth 140 feet.
(3) Water Level 66 feet below top of ground.
(4) Cased to 126, Size 2
(5) Screen: Size 1/4, Length 5'
(6) Were any formations sealed against pollution?
yes, no.

If YES depth of formation _____
Why _____
Drillers Remarks: _____

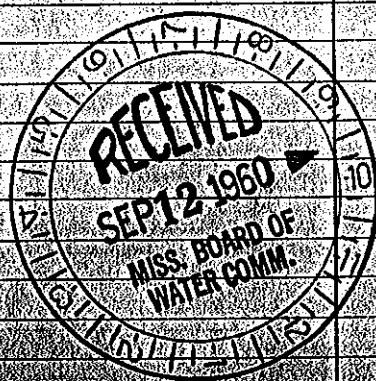

(Use Back Side)

WELL NO