

JASPER MISSISSIPPI BOARD OF WATER COMMISSIONERS

WATER WELL DRILLERS LOG

Date: 8-31-60 / 9/29/60, 1960, Driller: Le. K. Merritt County Jasper  
(Name)

(1) Owner of Land: Robert Lopez  
(Name)  
Rose Hill, Miss  
(Address)

(2) Location: 1/4, 1/4, Sec. 15 4N 12E  
(distance) 10 miles North of Hickory  
(direction) (Nearest Town)

(3) Topography:  (Hilly)  (Flat)  (Level)

(4) Purpose of Well: Domestic  
(Domestic Irrigation  
Municipal, Industrial, Other)

| Description & Color of Materials<br>Sand, Clay, Red Clay, Shell, etc. | Thick-<br>ness<br>Feet | Depth<br>Feet |
|---|------------------------|---------------|
| <u>tan fine clay + sand</u>   | <u>0</u>               | <u>18</u>     |
| <u>Blue clay, trace of</u>  |                        |               |
| <u>sand</u>   | <u>18</u>              | <u>30</u>     |
| <u>fine grey sand</u>   | <u>30</u>              | <u>38</u>     |
| <u>Dark clay + sand</u>   | <u>38</u>              | <u>84</u>     |
| <u>Medium fine grey sand</u>  | <u>84</u>              | <u>105</u>    |
| <u>Medium coarse sand</u>   | <u>105</u>             | <u>126</u>    |

Information upon completion of well:

(1) Diameter 2 inches.

(2) Total Depth 126 feet.


(3) Water Level 50 feet below top of ground.

(4) Cased to 120, Size 2

(5) Screen: Size 1/4, Length 6'

(6) Were any formations sealed against pollution?  
no  yes,  no.

If YES depth of formation \_\_\_\_\_  
Why \_\_\_\_\_  
Drillers Remarks: \_\_\_\_\_

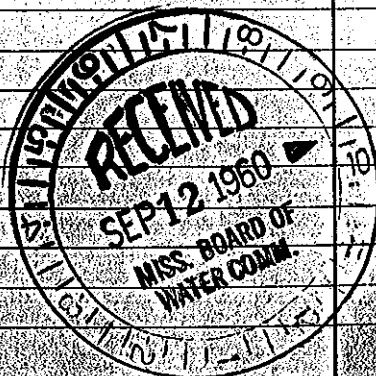

(Use Back Side)

Well No.

Mail this copy to Board of Water Commissioners 429 Miss. St. Jackson, Miss.