

JASPER MISSISSIPPI BOARD OF WATER COMMISSIONERS


WATER WELL DRILLERS LOG

Date: 9-15-64, Driller: M. McDonald & H. U. P. Co. County Jasper
 (Name)

(1) Owner of Land: J. C. Jay
 (Name)
Rt. #3, Newton, Miss
 (Address)
 (2) Location: 34 1/4 N 1/4
15 miles South of Hickory
 (distance) (direction) (Nearest Town)
 (3) Topography: X
 (Hilly) (Flat) (Level)
 (4) Purpose of Well: DOMESTIC
 (Domestic Irrigation, Municipal, Industrial, Other)

Description & Color of Materials Sand, Clay, Red Clay, Shell, etc.	Thick- ness Feet	Depth Feet
CLAY SAND	0	35
SHALE	35	82
SAND	82	120
SHALE	120	260
FINE SAND	260	290
SAND	290	310

Information upon completion of well:
 (1) Diameter 3/4 inches. TEST HOLE
 (2) Total Depth 310' feet.
 (3) Water Level 130' feet below top of ground.
 (4) Cased to 194', Size 4" BLACK
126', Size 2" BLACK
 (5) Screen: Size 2", Length 4'
STEEL
 (6) Were any formations sealed against pollution?
 _____ yes, _____ no.

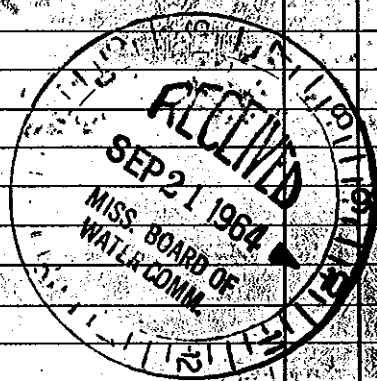

If YES depth of formation _____
 Why _____
 Drillers Remarks: 1-1" Pipe, P.C.C.

Well No.

(Use Back Side)