

C 8

WATER WELL DRILLERS LOG

11-22-63

Date: 11-22, 1963, Driller: Mc Donald Hill County Jasper
(Name)

(1) Owner of Land: <u>Marion Leggett</u> (Name)	Description & Color of Materials Sand, Clay, Red Clay, Shell, etc.	Thick- ness Feet	Depth Feet
(Address)	Clay	0	10
(2) Location: <u>1/4, 1/4, Sec. 27 4 N 12 E</u>	Sand	10	22
<u>10</u> miles <u>S</u> of <u>Hickory</u> (distance) (direction) (Nearest Town)	Thin shale st	22	38
(3) Topography: <u>Flat</u> (Hilly) (Flat) (Level)	shale	38	50
(4) Purpose of Well: <u>Domestic</u> (Domestic Irrigation Municipal, Industrial, Other)	limy shale	50	84
	lime & limy shale	34	98
	limy shale	98	120
	Sand	120	127
	shale w/ ad. sh.	127	134
	Brown shale	134	136
	old w/ shale streak	136	165


Information upon completion of well:

- (1) Diameter 3 7/8 inches.
- (2) Total Depth 165 feet.
- (3) Water Level 60 feet below top of ground.
- (4) Cased to 57, Size 4"
- (5) Screen: Size _____, Length _____
- (6) Were any formations sealed against pollution?
_____ yes, _____ no.

If YES depth of formation _____

Why _____

Drillers Remarks: _____

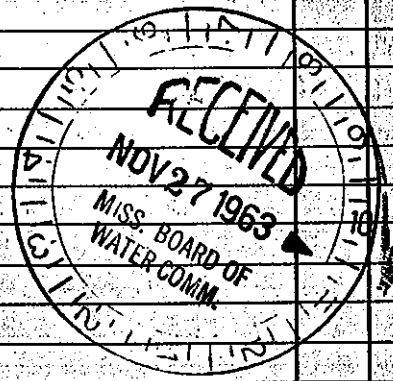

(Use Back Side)

Well No. 136