

JASPER, MISSISSIPPI BOARD OF WATER COMMISSIONERS

WATER WELL DRILLERS LOG

Card # P

9-1-60

Date: 9/1/60, 19\_\_ Driller: L. K. Merritt County Jasper

(Name)

(1) Owner of Land: <u>M. J. Barrett</u> (Name)	Description & Color of Materials Sand, Clay, Red Clay, Shell, etc.	Thick- ness Feet	Depth Feet
<u>R.D. Newton Miss.</u> (Address)	<u>Surge sand &amp; clay</u>	<u>0</u>	<u>21</u>
(2) Location: <u>1/4, 1/4, Sec. 22, 4N 13E</u> T. R.	<u>Fine grey sand</u>		
<u>10</u> miles <u>South</u> of <u>Hickory</u> (Distance) (Direction) (Nearest Town)	<u>cut with blue</u>	<u>21</u>	<u>70</u>
(3) Topography: <input checked="" type="checkbox"/> (Hilly) <input type="checkbox"/> (Flat) <input type="checkbox"/> (Level)	<u>Clay</u>		
(4) Purpose of Well: <u>Domestic</u> (Domestic, Irrigation, Municipal, Industrial, Other)	<u>Medium fine grey</u>	<u>70</u>	<u>80</u>
	<u>sand</u>		

Information upon completion of well:

(1) Diameter 2 inches.

(2) Total Depth 80 feet.

(3) Water Level 15 feet below top of ground.

(4) Cased to 69, Size 2


(5) Screen: Size 1/4, Length 6'

(6) Were any formations sealed against pollution?  
 yes,  no.

If YES depth of formation \_\_\_\_\_

Why \_\_\_\_\_

Drillers Remarks: \_\_\_\_\_

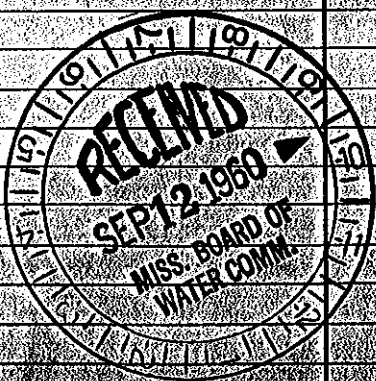

Well No. \_\_\_\_\_

(Use Back Side)

Mail this copy to Board of Water Commissioners 429 Miss. St. Jackson, Miss.