

JASPER MISSISSIPPI BOARD OF WATER COMMISSIONERS

WATER WELL DRILLERS LOG

Date: 10-8-60, 1960, Driller: Peoples & Rutledge County Jasper
 (Name)

(1) Owner of Land: Wayd Moulds
 (Name)
Rose Hill Miss
 (Address)

(2) Location: 1/4, 1/4, Sec 29 T4 R13E
3 miles East, of Rose Hill
 (distance) (direction) (Nearest Town)

(3) Topography: Hilly
 (Hilly) (Flat) (Level)

(4) Purpose of Well: Domestic
 (Domestic Irrigation
 Municipal, Industrial, Other)

Description & Color of Materials Sand, Clay, Red Clay, Shell, etc.	Thick- ness Feet	Depth Feet
<u>Yellow Sandy Clay</u>	<u>65</u>	<u>65</u>
<u>Blue shale & Rock</u>	<u>85</u>	<u>150</u>
<u>Gray Sandy Shale</u>	<u>10</u>	<u>160</u>
<u>Brown Sandy Shale</u>	<u>10</u>	<u>170</u>
<u>Sand shale streaks</u>	<u>40</u>	<u>210</u>
<u>White Sand</u>	<u>30</u>	<u>240</u>
<u>"Good"</u>		

Information upon completion of well:

(1) Diameter 2" inches.


(2) Total Depth 240 feet.

(3) Water Level 90' feet below top of ground.

(4) Cased to 240, Size 2"

(5) Screen: Size 2", Length 6'

(6) Were any formations sealed against pollution?
 _____ yes, _____ no.

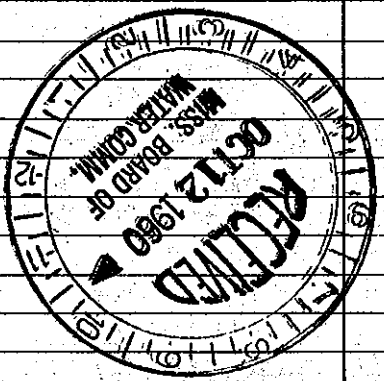

If YES depth of formation _____

Why _____

Drillers Remarks: _____

Retain this copy for your office files.

(Use Back Side)

Well No