

JASPER MISSISSIPPI BOARD OF WATER COMMISSIONERS

WATER WELL DRILLERS LOG

D-7
8-7-63

Date: 8-7, 1963, Driller: U. L. Welch County Jasper
(Name)

(1) Owner of Land: Harry Dean
(Name)
Hickory Miss
(Address)

(2) Location: SE 1/4, SE 1/4, Sec. 8 T4R13
9 miles S.E. of Hickory
(distance) (direction) (Nearest Town)

(3) Topography: (Flat) (Hilly) (Level)

(4) Purpose of Well: Domestic
(Domestic Irrigation, Municipal, Industrial, Other)

Description & Color of Materials Sand, Clay, Red Clay, Shell, etc.	Thick- ness Feet	Depth Feet
clay	16	0-16
blue sand	104	16-120
	50	120-170

Information upon completion of well:

(1) Diameter 2 inches.

(2) Total Depth 170 feet.

(3) Water Level 25 feet below top of ground.

(4) Cased to 170, Size 2"


(5) Screen: Size 2", Length 10'

(6) Were any formations sealed against pollution?
_____ yes, no.

If YES depth of formation _____

Why _____

Drillers Remarks: _____

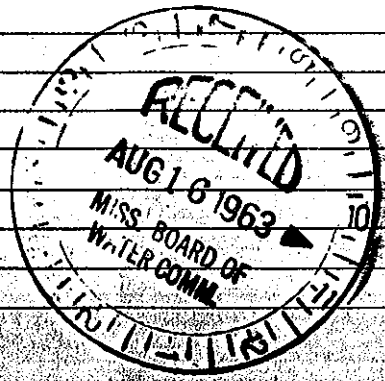

(Use Back Side)

Well No. 70

all this copy to Board of Water Commissioners 429 Miss. St. Jackson, Miss.