

JASPER MISSISSIPPI BOARD OF WATER COMMISSIONERS

2 D 8
8-8-63

WATER WELL DRILLERS LOG

Date: 8-8, 1963, Driller: W. L. Hulsh County Jasper
(Name)

(1) Owner of Land: <u>E. F. Gatcher</u> (Name)	Description & Color of Materials Sand, Clay, Red Clay, Shell, etc.	Thick- ness Feet	Depth Feet
<u>Hickory Miss</u> (Address)	<u>Red Clay</u>	<u>12</u>	<u>0-12</u>
(2) Location: <u>W 1/2, SW 1/4, Sec. 9 T4R13</u>	<u>S clay</u>	<u>18</u>	<u>12-30</u>
<u>9</u> miles <u>S. E.</u> of <u>Hickory</u> (distance) (direction) (Nearest Town)	<u>Blue</u>	<u>70</u>	<u>30-100</u>
(3) Topography: <u>U</u> (Hilly) (Flat) (Level)	<u>Sand</u>	<u>49</u>	<u>100-149</u>
(4) Purpose of Well: <u>Domestic</u> (Domestic Irrigation Municipal, Industrial, Other)			

Information upon completion of well:

(1) Diameter 2 inches.

(2) Total Depth 149 feet.

(3) Water Level 21 feet below top of ground.

(4) Cased to 149, Size 2"


(5) Screen: Size 2", Length 10'

(6) Were any formations sealed against pollution?
 yes, no.

If YES depth of formation _____

Why _____

Drillers Remarks: _____

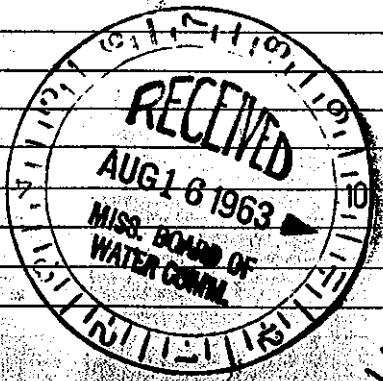

(Use Back Side)

Well No. 71

all this copy to Board of Water Commissioners 429 Miss. St. Jackson, Miss.