

JASPER MISSISSIPPI BOARD OF WATER COMMISSIONERS

D 9
9-23-64

WATER WELL DRILLERS LOG

Date: 9-23, 1964 Driller: W. L. Sheld County Jasper

(Name)

(1) Owner of Land:	Description & Color of Materials Sand, Clay, Red Clay, Shell, etc.	Thick- ness Feet	Depth Feet
<u>H. Hamrick</u> (Name)	<u>Red clay</u>	<u>32</u>	<u>0-32</u>
<u>Hickory Miss</u> (Address)	<u>Sandy clay</u>	<u>21</u>	<u>32-53</u>
(2) Location: <u>NW 1/4, S W 1/4, Sec. 4 T 4 R 3</u>	<u>Brown sody</u>	<u>23</u>	<u>53-75</u>
<u>8</u> miles <u>SE</u> , of <u>Hickory</u> (distance) (direction) (Nearest Town)	<u>Sand</u>	<u>61</u>	<u>75-136</u>
(3) Topography: <input checked="" type="checkbox"/> (Hilly) <input type="checkbox"/> (Flat) <input type="checkbox"/> (Level)			
(4) Purpose of Well: <u>Domestic</u> (Domestic Irrigation Municipal, Industrial, Other)			


Information upon completion of well:

- (1) Diameter 2 inches.
- (2) Total Depth 136 feet.
- (3) Water Level 3.3 feet below top of ground.
- (4) Cased to 136, Size 2"
- (5) Screen: Size 60 Length 10'
- (6) Were any formations sealed against pollution?
 yes, no.

If YES depth of formation _____

Why _____

Drillers Remarks: _____

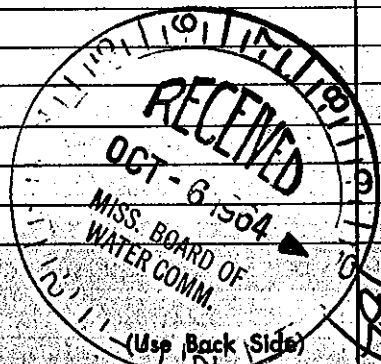

Well No. _____