

JASPER MISSISSIPPI BOARD OF WATER COMMISSIONERS

D10
6-18-65

WATER WELL DRILLERS LOG **CODED**

Date: 6-18, 1965, Driller: McDonald & Hill, Inc. County: Anderson

(1) Owner of Land: James Lopez
(Name)
Rt. #1 Rose Hill, Miss.
(Address)

(2) Location: 1/4, 1/4, Sec. 8 T4 R13,
3 miles NW of Rose Hill
(distance) (direction) (Nearest Town)

(3) Topography: (Hilly) (Flat) (Level)

(4) Purpose of Well: Domestic
(Domestic Irrigation, Municipal, Industrial, Other)

Description & Color of Materials Sand, Clay, Red Clay, Shell, etc.	Thick- ness Feet	Depth Feet
Clay & sand	0	12
lime shale	12	20
H shale	20	103
C sand	103	175
Brown shale	175	185
lime rock	185	194
green blk sand o-shell	195	200
H shale m shale	200	240
lime rock	240	262
gr. blk sand white	262	295
shale, lime rock, sand	295	350

Information upon completion of well:

(1) Diameter 4 inches.

(2) Total Depth 350 feet.


(3) Water Level 45 feet below top of ground.

(4) Cased to 218, Size 4

(5) Screen: Size _____, Length _____

(6) Were any formations sealed against pollution?
_____ yes, no.

CODED

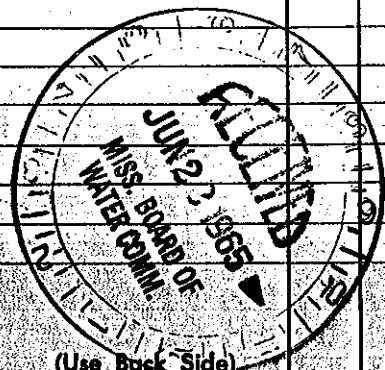

Well No.

Mail this copy to Board of Water Commissioners 429 Miss. St. Jackson, Miss.