

JASPER

BOARD OF WATER COMMISSIONERS

# WATER WELL DRILLERS LOG

8-10-64

Date: 8-10, 1964, Driller: M<sup>c</sup>Donald H. Inc County JASPER

(Name)

(1) Owner of Land: TOM LEWIS  
 (Name)  
ROSE HILL MISS  
 (Address)

(2) Location: 1/4, 1/4, Sec. 33 T 4N R 13E  
 \_\_\_\_\_ miles \_\_\_\_\_ of \_\_\_\_\_  
 (distance) (direction) (Nearest Town)

(3) Topography: X  
 (Hilly) (Flat) (Level)

(4) Purpose of Well: Domestic  
 (Domestic Irrigation  
 Municipal, Industrial, Other)

Description & Color of Materials Sand, Clay, Red Clay, Shell, etc.	Thick- ness Feet	Depth Feet
<u>CLAY</u>	<u>0</u>	<u>17</u>
<u>SHALE</u>	<u>17</u>	<u>105</u>
<u>FINE SAND</u>	<u>105</u>	<u>135</u>
<u>SAND</u>	<u>135</u>	<u>150</u>

### Information upon completion of well:

(1) Diameter 3 1/4 TEST HOLE inches.

(2) Total Depth 150' feet.

(3) Water Level 85' feet below top of ground.

(4) Cased to 147', Size 2"

(5) Screen: Size 2", Length 5'  
1-2" LINE CYLINDER.


(6) Were any formations sealed against pollution?  
 \_\_\_\_\_ yes, \_\_\_\_\_ no.

BRASS

If YES depth of formation \_\_\_\_\_

Why \_\_\_\_\_

Drillers Remarks: WILL NEED 120'

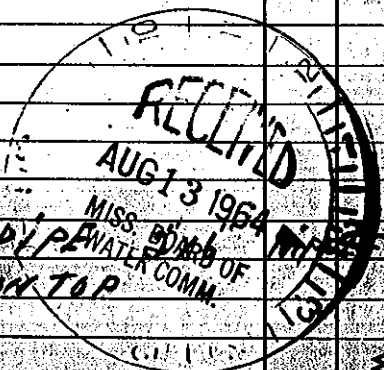

(Use Back Side)

Well No.

Retain this copy for your office files.