

JASPER

9 P

# WATER WELL DRILLERS LOG

Date: 12-31-64, 1964, Driller: M. C. Donald & H. W. Lee County JASPER  
(Name)

(1) Owner of Land: Holly REYNOLDS  
(Name)

ROSE HILL MISS  
(Address)

(2) Location: 1/4, 1/4, Sec. 28 4N 13E  
T R  
miles \_\_\_\_\_, of \_\_\_\_\_  
(distance) (direction) (Nearest Town)

(3) Topography: X  
(Hilly) (Flat) (Level)

(4) Purpose of Well: DOMESTIC  
(Domestic Irrigation  
Municipal, Industrial, Other)

Description & Color of Materials Sand, Clay, Red Clay, Shell, etc.	Thick- ness Feet	Depth Feet
CLAY	8	20
FINE SAND ST CLAY	20	60
SAND	60	

### Information upon completion of well:

(1) Diameter 2" WELL inches.

(2) Total Depth 75' feet.

(3) Water Level 42' feet below top of ground.

(4) Cased to 68', Size 2"


(5) Screen: Size 2", Length 1' BRASS  
63' 1" GALV PIPE

(6) Were any formations sealed against pollution?  
1- 2" JET PACKAGE  
yes, no.  
1- 2" LINE CYLINDER

If YES depth of formation \_\_\_\_\_

Why \_\_\_\_\_

Drillers Remarks: \_\_\_\_\_

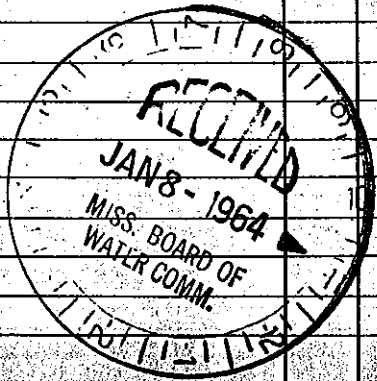

Well No. \_\_\_\_\_

(Use Back Side)

Retain this copy for your office files.