

WATER WELL DRILLERS LOG

Date: 8/25/60 1960, Driller: L. K. McCreath County: Taylor

(1) Owner of Land: C. A. Appled
(Name)
Rose Hill, Miss
(Address)

(2) Location: 1/4, 1/4, Sec 24 4N 13E
(distance) (direction) (Nearest Town)

(3) Topography: (Hilly) (Flat) (Level)

(4) Purpose of Well: Domestic
(Domestic Irrigation, Municipal, Industrial, Other)

Description & Color of Materials Sand, Clay, Red Clay, Shell, etc.	Thick- ness Feet	Depth Feet
Orange clay sand	0	10
Blue sand	10	18
Red clay	18	53
Red clay	52	5
<u>Orange Clay + Sand</u>	<u>0</u>	<u>10</u>
<u>Blue Clay, trace of sand</u>	<u>12</u>	<u>20</u>
<u>Trace sand + Blue Clay</u>	<u>20</u>	<u>28</u>
<u>Milum Fine Sand</u>	<u>38</u>	<u>54</u>
<u>Blue Clay</u>	<u>54</u>	<u>58</u>

Information upon completion of well:

(1) Diameter 2 inches.

(2) Total Depth 58 feet.

(3) Water Level 30 feet below top of ground.

(4) Cased to 48, Size 2


(5) Screen: Size 1/4, Length 6

(6) Were any formations sealed against pollution?
 yes, no,

If YES depth of formation _____

Why _____

Drillers Remarks: _____

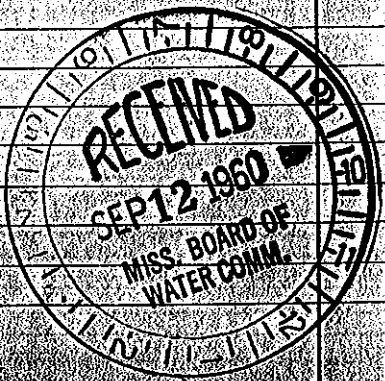

Well No.

(Use Back Side)

Mail this copy to Board of Water Commissioners 429 Miss. St. Jackson, Miss