

**JASPER MISSISSIPPI BOARD OF WATER COMMISSIONERS**

6 D 18  
7-65

**WATER WELL DRILLERS LOG**


Date: July, 1965, Driller: Pepper Drilling Co. Jasper  
(Name)

(1) Owner of Land:	Description & Color of Materials Sand, Clay, Red Clay, Shell, etc.	Thick- ness Feet	Depth Feet
<u>Faulkner</u> (Name) <u>Rose Hill, Miss</u> (Address)	<u>yellow sandy clay</u>	<u>12</u>	<u>12</u>
(2) Location: <u>1/4</u> , <u>1/4</u> , Sec. <u>31</u> <u>4N 13E</u> T. R.	<u>Yellow Sand</u>	<u>26</u>	<u>38</u>
<u>Town of Rose Hill</u> miles (distance), of (direction), (Nearest Town)	<u>Blue clay</u>	<u>6</u>	<u>42</u>
(3) Topography: <u>Hilly</u> (Hilly) (Flat) (Level)	<u>White Sand</u>	<u>13</u>	<u>55</u>
(4) Purpose of Well: <u>Home</u> (Domestic Irrigation, Municipal, Industrial, Other)			

**Information upon completion of well:**

- (1) Diameter 2 inches.
- (2) Total Depth 55 feet.
- (3) Water Level 37 feet below top of ground.
- (4) Cased to 49, Size 2
- (5) Screen: Size 2, Length 6
- (6) Were any formations sealed against pollution?  
\_\_\_\_\_ yes, \_\_\_\_\_ no.

If YES depth of formation \_\_\_\_\_  
Why \_\_\_\_\_  
Drillers Remarks: \_\_\_\_\_

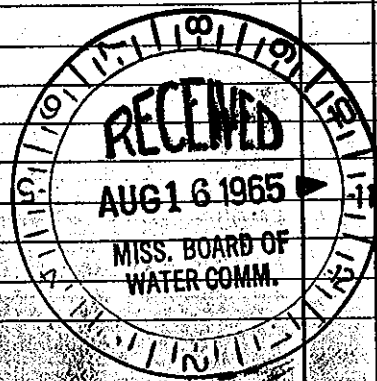

(Use Back Side)

Well No.

Mail this copy to Board of Water Commissioners 429 Miss. St. Jackson, Miss.