

MISSISSIPPI BOARD OF WATER COMMISSIONERS

13

WATER WELL DRILLERS LOG

9-2-63

Date: 9-2, 1963, Driller: U. L. Hald County Jones  
 (Name)


(1) Owner of Land: Jewel H. Boggan  
 (Name)  
Hickory  
 (Address)  
 (2) Location: SE 1/4, NE 1/4, Sec. 15 T4 R13  
8 miles SE of Hickory  
 (distance) (direction) (Nearest Town)  
 (3) Topography: \_\_\_\_\_  
 (Hilly) (Flat) (Level)  
 (4) Purpose of Well: Domestic  
 (Domestic Irrigation, Municipal, Industrial, Other)

Description & Color of Materials Sand, Clay, Red Clay, Shell, etc.	Thick- ness Feet	Depth Feet
<u>S Clay</u>		<u>220-22</u>
<u>Blue</u>		<u>2122-49</u>
<u>Sand</u>		<u>3743-86</u>

Information upon completion of well:

(1) Diameter 3 1/2 inches.  
 (2) Total Depth 80 feet.  
 (3) Water Level 12 feet below top of ground.  
 (4) Cased to 80, Size 2"  
 (5) Screen: Size 3", Length 10'  
 (6) Were any formations sealed against pollution?  
 \_\_\_\_\_ yes,  no.

If YES depth of formation \_\_\_\_\_  
 Why \_\_\_\_\_  
 Drillers Remarks: \_\_\_\_\_

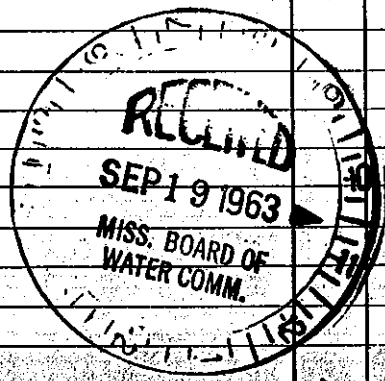

Well No. 75

(Use Back Side)

Mail this copy to Board of Water Commissioners 429 Miss. St. Jackson, Miss.