

**JASPER MISSISSIPPI BOARD OF WATER COMMISSIONERS**

D20

**WATER WELL DRILLERS LOG**


11-2-63

Date: 11-2, 1963, Driller: McDaniel & Hill County Jasper  
(Name)

(1) Owner of Land:	Description & Color of Materials Sand, Clay, Red Clay, Shell, etc.	Thick- ness Feet	Depth Feet
<u>J.F. Walker</u> (Name)	<u>Clay</u>	<u>0</u>	<u>7</u>
<u>Rose Hill, Miss.</u> (Address)	<u>Sand</u>	<u>7</u>	<u>38</u>
(2) Location: $\frac{1}{4}$ , $\frac{1}{4}$ , Sec. <u>9</u> <u>4N 13E</u> T. R.			
<u>10 miles West</u> , of <u>Centerville</u> (distance) (direction) (Nearest Town)			
(3) Topography: <u>Hilly</u> (Hilly) (Flat) (Level)			
(4) Purpose of Well: <u>Domestic</u> (Domestic Irrigation Municipal, Industrial, Other)			

**Information upon completion of well:**

- (1) Diameter 3 7/8 inches.
- (2) Total Depth 38 feet.
- (3) Water Level 30 feet below top of ground.
- (4) Cased to 33, Size 2"
- (5) Screen: Size 2", Length 0"
- (6) Were any formations sealed against pollution?  
\_\_\_\_\_yes, \_\_\_\_\_no.

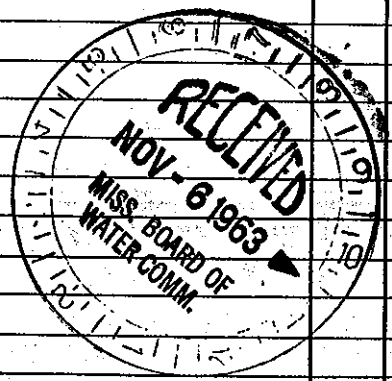

If YES depth of formation \_\_\_\_\_  
Why \_\_\_\_\_  
Drillers Remarks: \_\_\_\_\_

(Use Back Side)

Well No  
127

all this copy to Board of Water Commissioners 429 Miss. St. Jackson, Miss.