

JASPER

MISSISSIPPI BOARD OF WATER COMMISSIONERS

WATER WELL DRILLERS LOG

11-15-63

Date: 11-15, 1963, Driller: McDaniel & Hill County Jasper

(Name)

(1) Owner of Land: Luther E. Cheney  
 (Name)  
Rt #2, Enterprise, Miss  
 (Address)  
 (2) Location: 9 1/4 N 13E  
 1/4, 1/4, Sec. 9 T. R.  
10 miles west of Enterprise  
 (distance) (direction) (Nearest Town)  
 (3) Topography: Hilly  
 (Hilly) (Flat) (Level)  
 (4) Purpose of Well: Domestic  
 (Domestic Irrigation  
 Municipal, Industrial, Other)

Description & Color of Materials Sand, Clay, Red Clay, Shell, etc.	Thick- ness Feet	Depth Feet
Clay	0	10
Sand	10	16
Shale	16	37
Sd. sdy clay	37	45
Sd.	45	78
Shale	78	90
Sd.	90	170
shale streaks	170	180
Shale	180	190
sh. w/ shale streaks	190	198
shale	198	222
lime - limy shale	222	243
limy sand	243	248
sd. shale	248	254
Sd.	254	258
shale	258	265
shale w/ lime streaks	265	321
Sd. w/ lime rock	321	326
shale w/ lime st.	326	340
st. sand @	340	


Information upon completion of well:

(1) Diameter 3 7/8 inches.  
 (2) Total Depth 340 feet.  
 (3) Water Level 66 feet below top of ground.  
 (4) Cased to 264, Size 4"  
 (5) Screen: Size \_\_\_\_\_, Length \_\_\_\_\_  
 (6) Were any formations sealed against pollution?  
 \_\_\_\_\_ yes, \_\_\_\_\_ no.

If YES depth of formation \_\_\_\_\_

Why \_\_\_\_\_

Drillers Remarks: \_\_\_\_\_

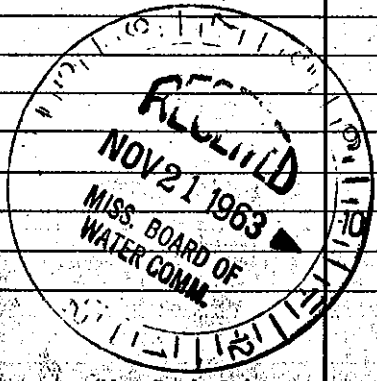

(Use Back Side)

Well No 131

all this copy to Board of Water Commissioners 429 Miss. St. Jackson, Miss