

JASPER MISSISSIPPI BOARD OF WATER COMMISSIONERS

D22  
6-15-64

WATER WELL DRILLERS LOG

Date: 6-15, 1964, Driller: M<sup>e</sup> Donald & H<sup>v</sup> County Jasper  
(Name)

(1) Owner of Land: MONROE LEWIS  
(Name)  
ROSE HILL MISS  
(Address)

(2) Location:  $\frac{1}{4}$ ,  $\frac{1}{4}$ , Sec. 32 T 4N R 13E  
1/2 miles N.E. of Rose Hill, Miss  
(distance) (direction) (Nearest Town)

(3) Topography: X  
(Hilly) (Flat) (Level)

(4) Purpose of Well: DOMESTIC  
(Domestic Irrigation, Municipal, Industrial, Other)

Description & Color of Materials Sand, Clay, Red Clay, Shell, etc.	Thick- ness Feet	Depth Feet
CLAY	0	10
SAND	10	30
SHALE	30	64
SAND	64	105

Information upon completion of well:

(1) Diameter 3/4 inches TEST HOLE

(2) Total Depth 105' feet.

(3) Water Level 64' feet below top of ground.

(4) Cased to 100, Size 2"


(5) Screen: Size 2", Length 5'

(6) Were any formations sealed against pollution?  
\_\_\_\_\_ yes, \_\_\_\_\_ no.

If YES depth of formation \_\_\_\_\_

Why \_\_\_\_\_

Drillers Remarks: \_\_\_\_\_

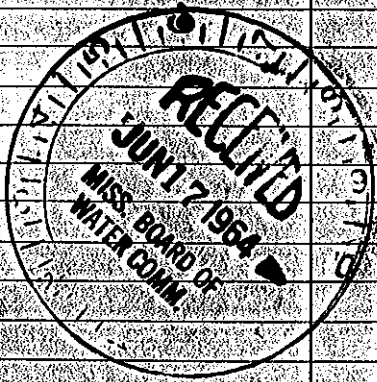

(Use Back Side)

Well No.