

JASPER MISSISSIPPI BOARD OF WATER COMMISSIONERS

D 23

WATER WELL DRILLERS LOG

8-30-63

Date: 8-30, 1963, Driller: V. L. Welch County Jasper

(Name)

(1) Owner of Land: Earl Chatham
(Name)
Rose Hill Miss
(Address)

(2) Location: SE 1/4, SW 1/4, Sec. 30 T4 R13
1 miles N of Rock Hill
(distance) (direction) (Nearest Town)

(3) Topography: (Hilly) (Flat) (Level)

(4) Purpose of Well: Domestic
(Domestic Irrigation
Municipal, Industrial, Other)

| Description & Color of Materials Sand, Clay, Red Clay, Shell, etc. | Thick- ness Feet | Depth Feet |
|---|------------------------|----------------|
| <u>Sand clay</u> | <u>62</u> | <u>0-32</u> |
| <u>Blue</u> | <u>32</u> | <u>32-64</u> |
| <u>Shell</u> | <u>63</u> | <u>64-127</u> |
| <u>Brown</u> | <u>75</u> | <u>127-202</u> |
| <u>Sand</u> | <u>62</u> | <u>202</u> |

Information upon completion of well:

(1) Diameter 3 1/2 inches.

(2) Total Depth 262 feet.

(3) Water Level 30 feet below top of ground.

(4) Cased to 262, Size 7"


(5) Screen: Size 2", Length 10'

(6) Were any formations sealed against pollution?
 yes, no.

If YES depth of formation 30

Why _____

Drillers Remarks: _____

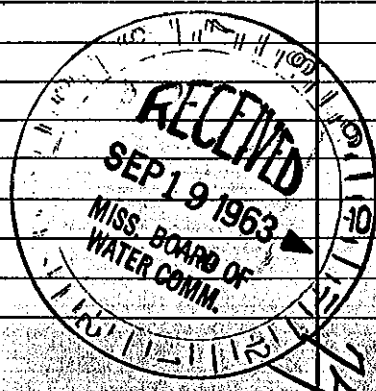

(Use Back Side)

Well No

all this copy to Board of Water Commissioners 429 Miss. St. Jackson, Miss