

JASPER MISSISSIPPI BOARD OF WATER COMMISSIONERS

WATER WELL DRILLERS LOG

5-29-63


Date: 5-29, 1963, Driller: Mc Donald & Hill County Jasper

(1) Owner of Land: Maude  
 (Name)  
 (Address)  
 (2) Location: 1/4, 1/4, Sec. 13 4N13E T. R.  
8 miles west, of Calipatria  
 (distance) (direction) (Nearest Town)  
 (3) Topography: Hilly  
 (Hilly) (Flat) (Level)  
 (4) Purpose of Well: Domestic  
 (Domestic Irrigation, Municipal, Industrial, Other)

Description & Color of Materials Sand, Clay, Red Clay, Shell, etc.	Thick- ness Feet	Depth Feet
Clay	0	8
sd & clay	8	20
shale	25	38
sd & limy shale	38	65
sd & sdy shale	65	73
sd. w/ shale breaks	73	83
sd.	83	120
shale	120	235
Hard lime	235	260
sd w/ lime st.	260	261
shale	261	273
lime & limy shale	273	293
limy sd & lime	293	305
sd.	305	315
shale	315	320
sd & lime	320	330
lime & limy shale	330	343
sd & lime	343	393
sd & limy shale	393	410

Information upon completion of well:

(1) Diameter: 3 1/4 inches.  
 (2) Total Depth: 410 feet.  
 (3) Water Level: 50 feet below top of ground.  
 (4) Cased to: 238, Size 4"  
 (5) Screen: Size \_\_\_\_\_, Length \_\_\_\_\_  
 (6) Were any formations sealed against pollution?  
 \_\_\_\_\_ yes, \_\_\_\_\_ no.

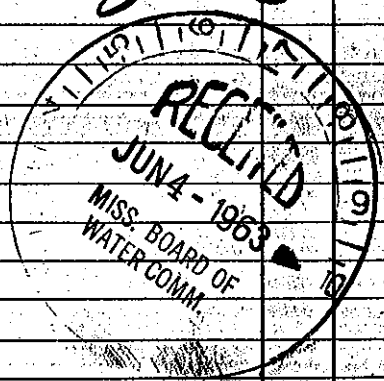

If YES depth of formation \_\_\_\_\_  
 Why \_\_\_\_\_  
 Drillers Remarks: \_\_\_\_\_

(Use Back Side)

Well No

Mail this copy to Board of Water Commissioners 429 Miss. St. Jackson, Miss