

MISSISSIPPI BOARD OF WATER COMMISSIONERS

Handwritten: ~~Jasper~~
 Jasper
 D-2527
 11-2-63

WATER WELL DRILLERS LOG

Jasper
 Handwritten signature

Date: 11-2, 1963, Driller: U. L. Helder County: Jasper

(Name)

(1) Owner of Land: Roy Williams
(Name)
Hickory Miss
(Address)

(2) Location: NE 1/4, SE 1/4, Sec 5 T4R13
8 miles S of Hickory
(distance) (direction) (Nearest Town)

(3) Topography: (Hilly) (Flat) (Level)

(4) Purpose of Well: Domestic
(Domestic Irrigation
 Municipal, Industrial, Other)

Description & Color of Materials
 Sand, Clay, Red Clay, Shell, etc.

Thick-
 ness
 Feet

Depth
 Feet

Red clay 11-11
sand 95 11-106

Information upon completion of well:

(1) Diameter 3 1/2 inches.

(2) Total Depth 106 feet.


(3) Water Level 32 feet below top of ground.

(4) Cased to 106, Size 2"

(5) Screen: Size 2", Length 10'

(6) Were any formations sealed against pollution?
 yes, no.

If YES depth of formation _____
 Why _____
 Drillers Remarks: _____

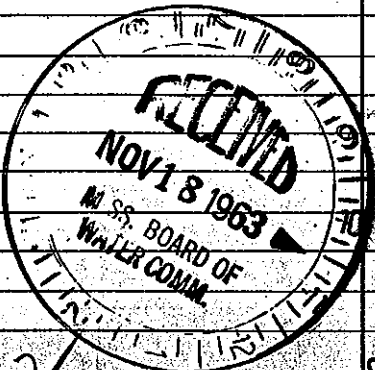

(Use Back Side)

Well No.

83

Mail this copy to Board of Water Commissioners 429 Miss. St. Jackson, Miss.