

JASPER MISSISSIPPI BOARD OF WATER COMMISSIONERS

WATER WELL DRILLERS LOG

CODED

9-5-63

Date: 9-5-1963, Driller: Layne-Central Co. County Jasper

(1) Owner of Land: Town of Louin
 (Name)
Louin, Mississippi
 (Address)

(2) Location: 1/4, 1/4, Sec. 27 T3R10
 (distance) (direction) (Nearest Town)

(3) Topography: _____
 (Hilly) (Flat) (Level)

(4) Purpose of Well: Municipal
 (Domestic Irrigation
 Municipal, Industrial, Other)

Description & Color of Materials Sand, Clay, Red Clay, Shell, etc.	Thick- ness Feet	Depth Feet
red sandy clay	20	20
gummy clay	10	30
fine hard sand	10	40
blue gummy clay	42	82
clay st. fine sand	10	92
blue gummy clay	102	194
brittle clay	194	288
white chalk stks.		
soap stone	44	332
shale & shell	40	372
hard blue shale	8	380
fine sand st. shale	10	390
fine sand	45	435

Information upon completion of well:

(1) Diameter 6" inches.

(2) Total Depth 435' feet.

(3) Water Level 85' feet below top of ground.

(4) Cased to 380', Size 6"

(5) Screen: Size 4", Length 40'


(6) Were any formations sealed against pollution?
X yes, _____ no.

If YES depth of formation 380'

Why required

Drillers Remarks:

CODED

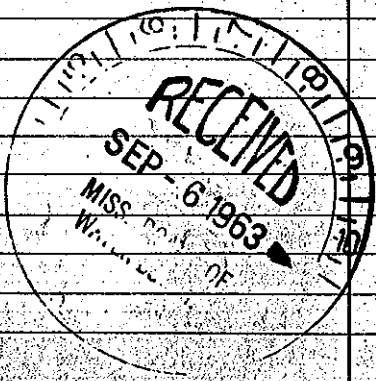

Well No.

(Use Back Side)

Mail this copy to Board of Water Commissioners 429 Miss. St. Jackson, Miss