

**JASPER MISSISSIPPI BOARD OF WATER COMMISSIONERS**

**WATER WELL DRILLERS LOG**

2 E 6  
7-65

5

Date: \_\_\_\_\_, 19\_\_\_\_, Driller: McDONALD HILL County LAUDERDALE  
(Name)

(1) Owner of Land: Colbert ULMER  
(Name)  
MONT ROSE  
(Address)

(2) Location: NE 1/4, SW 1/4, Sec. 1 3N R10  
(distance) (direction) (Nearest Town)

(3) Topography: Hilly  
(Hilly) (Flat) (Level)

(4) Purpose of Well: DOMESTIC  
(Domestic Irrigation  
Municipal, Industrial, Other)

Description & Color of Materials Sand, Clay, Red Clay, Shell, etc.	Thick- ness Feet	Depth Feet
<u>CLAY</u>	<u>0</u>	<u>25</u>
<u>Limy shale</u>	<u>25</u>	<u>100</u>
<u>M Limestone</u>	<u>100</u>	<u>160</u>
<u>MTO H Limy shale</u>	<u>160</u>	<u>200</u>
<u>Soft shale</u>	<u>200</u>	<u>210</u>
<u>Fine sand sandy shale</u>	<u>210</u>	<u>240</u>

Information upon completion of well:

(1) Diameter 4 inches.


(2) Total Depth 240 feet.

(3) Water Level 50 feet below top of ground.

(4) Cased to 42, Size 4

(5) Screen: Size \_\_\_\_\_, Length \_\_\_\_\_

(6) Were any formations sealed against pollution?  
\_\_\_\_\_ yes, ✓ no.

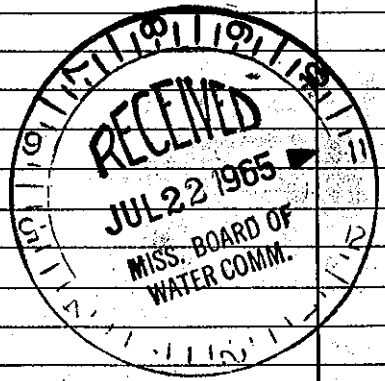

If YES depth of formation \_\_\_\_\_

Why \_\_\_\_\_

Drillers Remarks: \_\_\_\_\_

(Use Back Side)

Well No.

Mail this copy to Board of Water Commissioners 429 Miss. St. Jackson, Miss.