

5 JASPER
E 9
11-8-62

WATER WELL DRILLERS LOG

Date: 11-8-62, 1962, Driller: Frank Stelling, Jasper County, Miss.


(1) Owner of Land: M.V. Carley
(Name)
Lorain, Miss
(Address)
(2) Location: 1/4, 1/4, Sec. 28 3N 10E
1/4 miles West of Lorain
(distance) (direction) (Nearest Town)
(3) Topography: X
(Hilly) (Flat) (Level)
(4) Purpose of Well: Home
(Domestic Irrigation
Municipal, Industrial, Other)

Description & Color of Materials Sand, Clay, Red Clay, Shell, etc.	Thick- ness Feet	Depth Feet
Brown Clay	0	15
Blue Clay		218
Shale + Rock		322
Rock		332
Sandy Shell		342
Shell + Clay		352
Fine Sand + Shls Clay		392
Clay + Shls Sand		402
Fine Sand		430

Information upon completion of well:

(1) Diameter 2" inches.
(2) Total Depth 430 feet.
(3) Water Level 65 feet below top of ground.
(4) Cased to 420, Size 2"
(5) Screen: Size 2", Length 10 ft.
(6) Were any formations sealed against pollution?
yes, X no.

If YES depth of formation _____
Why _____
Drillers Remarks: _____

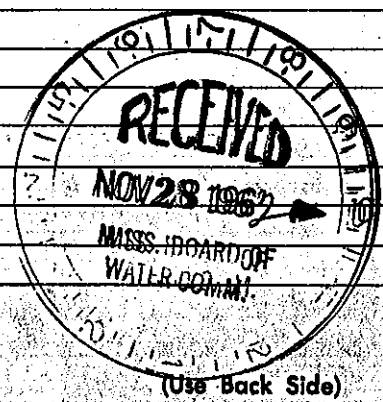

Well No.

Mail this copy to Board of Water Commissioners 429 Miss. St. Jackson, Miss.