

JASPER MISSISSIPPI BOARD OF WATER COMMISSIONERS

SE 10
9-11-63

WATER WELL DRILLERS LOG

Date: 9-11, 1963, Driller: Jasper Drilling Co. County: Jasper
(Name)

(1) Owner of Land: J.H. Bruntt
(Name)
Rt one Leuin, Miss.
(Address)

(2) Location: 1/4, 1/4, Sec. 30 3N 10E
3 miles West of Leuin
(distance) (direction) (Nearest Town)

(3) Topography: _____
(Hilly) (Flat) (Level)

(4) Purpose of Well: Home
(Domestic Irrigation, Municipal, Industrial, Other)

Description & Color of Materials Sand, Clay, Red Clay, Shell, etc.	Thick- ness Feet	Depth Feet
Brown Clay	0	5
Sand + Clay		16
Sand		25
Clay + Sand		32
Blue Clay		232
Shale		252
Shale + Lime		282
Shale + the Rock		304
Rock		307
Shale		323
Rock		326
Clay + Sandy Shell		336
Sandy Shell		346
Fine Sand + Clay		356
Fine Sand		374
Med. Sand + fth sand		426
Fine Sand + Clay		436
Fine Sand		454
Fine Sand		480

Information upon completion of well:

(1) Diameter 2 inches.

(2) Total Depth 480 feet.

(3) Water Level 21 feet below top of ground.

(4) Cased to 470, Size 2"


(5) Screen: Size 2", Length 10ft

(6) Were any formations sealed against pollution?
_____ yes, X no.

If YES depth of formation _____

Why _____

Drillers Remarks: _____

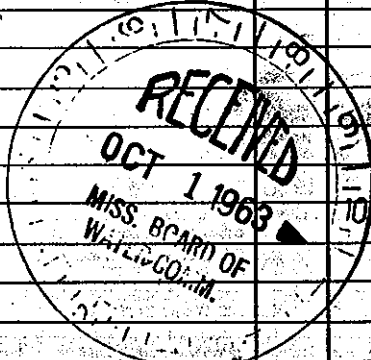

Well No _____

(Use Back Side)

Mail this copy to Board of Water Commissioners 429 Miss. St. Jackson, Miss.