

JASPER MISSISSIPPI BOARD OF WATER COMMISSIONERS

SE 1
9-25-63

WATER WELL DRILLERS LOG

Jasper

Date: 9/25, 1963, Driller: Forest Dwyer County Scott
(Name)

(1) Owner of Land: C.O. Carr
(Name)
Lozin Miss.
(Address)

(2) Location: 30 ^{3N} 10E ^R
3 miles West Lozin
(distance) (direction) (Nearest Town)

(3) Topography: X
(Hilly) (Flat) (Level)

(4) Purpose of Well: Chickens
(Domestic Irrigation
Municipal, Industrial, Other)

Description & Color of Materials Sand, Clay, Red Clay, Shell, etc.	Thick- ness Feet	Depth Feet
<u>Brown Clay</u>	<u>0</u>	<u>22</u>
<u>Blue clay</u>	<u>257</u>	
<u>Rock + Shell</u>	<u>297</u>	
<u>Shale</u>	<u>307</u>	
<u>Clay + Shells Shell</u>	<u>333</u>	
<u>Shale</u>	<u>353</u>	
<u>Shale + Shells Sand</u>	<u>423</u>	
<u>Fine sand + Shells Clay</u>	<u>433</u>	
<u>Shale + Shells Sand</u>	<u>443</u>	
<u>Shale + Shells fine sand</u>	<u>473</u>	
<u>Fine sandy + Shells shale</u>	<u>483</u>	
<u>fine sand</u>	<u>493</u>	
<u>Clay</u>		

Information upon completion of well:

(1) Diameter 2 inches.

(2) Total Depth 493 feet.

(3) Water Level 98 feet below top of ground.

(4) Cased to 493, Size 2".


(5) Screen: Size 2", Length 10.

(6) Were any formations sealed against pollution?
yes, X no.

If YES depth of formation _____

Why _____

Drillers Remarks: _____

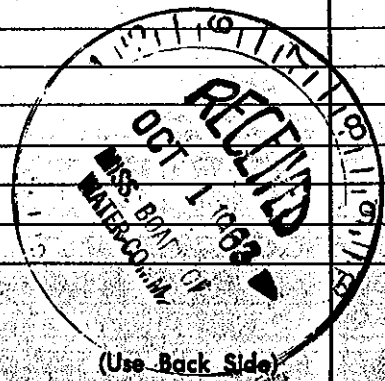

(Use Back Side)

Well No.

Mail this copy to Board of Water Commissioners 429 Miss. St. Jackson, Miss.