

MISSISSIPPI BOARD OF WATER COMMISSIONERS

5-20-66

WATER WELL DRILLERS LOG

Date: 5-20, 1966, Driller: LEACH County: Jasper  
 (When well drilled) (Name) (Where well is located)

1) Owner of Land	Description & Color of Materials	Thick-ness Feet	Depth Feet
<u>Minnie Jones</u> (Name)	<u>yellow clay</u>	<u>20</u>	<u>20</u>
<u>Montrose Miss</u> (Address)	<u>Blue clay</u>	<u>110</u>	<u>130</u>
2) Location: <u>1/4</u> , <u>1/4</u> , Sec. <u>10</u> T. <u>3N</u> R. <u>10E</u>	<u>Rocky</u>	<u>30</u>	<u>160</u>
<u>2</u> miles <u>West</u> of <u>Montrose</u>	<u>Sand</u>	<u>160</u>	<u>260</u>
3) Topography: <input checked="" type="checkbox"/> (Hilly) <input checked="" type="checkbox"/> (Flat) <input type="checkbox"/> (Level)			
4) Purpose of Well: <input checked="" type="checkbox"/> (Domestic Irrigation) <input type="checkbox"/> (Municipal, Industrial, Other)			

Information upon completion of well:

1) Diameter: 2 inches.


2) Total Depth: 260 feet.

3) Water Level: 10' feet below top of ground.

4) Cased to: 255, Size 2"

5) Screen: Size 2 1/2", Length 5'

6) Were any formations sealed against pollution?  
 yes,  no.

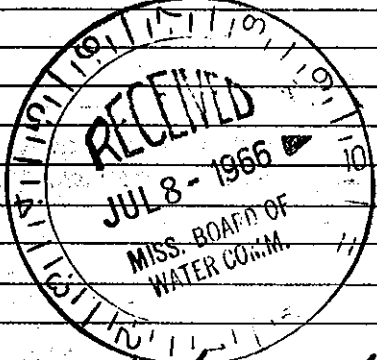

YES depth of formation \_\_\_\_\_

Why: was still in good sand at this depth

Drillers Remarks: \_\_\_\_\_

Yield in gpm: 20

Size pump: 1 1/2 HP

Type power: Electric

Total: 260

Mail this copy to Board of Water Commissioners 429 Miss. St. Jackson, Miss.