

MISSISSIPPI BOARD OF WATER COMMISSIONERS

WATER WELL DRILLERS LOG

11-7-60

Date: 11/7, 1960, Driller: James McGee County: Jasper

(1) Owner of Land: J. D. Gregory  
 (Name)  
Montrose, Miss.  
 (Address)

(2) Location: NW 1/4, NW 1/4, Sec. 12, T. 3 R. 10  
16 miles South of Newton  
 (distance) (direction) (Nearest Town)

(3) Topography:  (Hilly)  (Flat)  (Level)

(4) Purpose of Well: Domestic  
 (Domestic Irrigation, Municipal, Industrial, Other)

Description & Color of Materials Sand, Clay, Red Clay, Shell, etc.	Thick- ness Feet	Depth Feet
red clay.	0-	12
Sand.	12-	29
Brown clay & sand.	29-	40
Blue clay.	40-	82
Gumbo.	82-	202
Clay & stks. rock.	202-	232
Clay.	232-	259
Rock.	259-	262
Clay.	262-	272
Clay & sandy shell.	272-	292
Fine sand & clay.	292-	302
Mucky clay.	302-	312
Clay & stks. sand.	312-	325
Fine sand.	325-	332
Mucky clay & sand.	332-	346
Sand. (Screen Set)	346-	376

Information upon completion of well:

(1) Diameter 2 inches.

(2) Total Depth 367 feet.

(3) Water Level 116 feet below top of ground.

(4) Cased to 357, Size 2"


(5) Screen: Size 2", Length 10'

(6) Were any formations sealed against pollution?  
 \_\_\_\_\_ yes,  no.

If YES depth of formation \_\_\_\_\_

Why \_\_\_\_\_

Drillers Remarks: Good well.

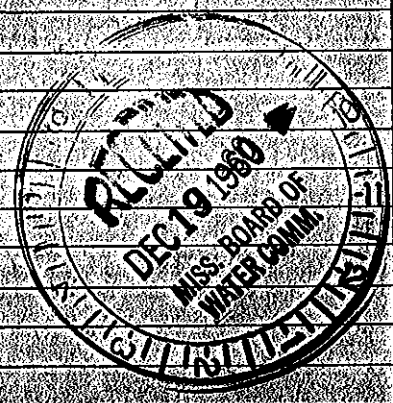

(Use Back Side)

Well No.

Mail this copy to Board of Water Commissioners 429 Miss. St. Jackson, Miss.