

**C. P. CLARK**  
**WATER WELL DRILLING**  
 ROUTE 2

MISSISSIPPI LAUREL, MISS. 39440  
 BOARD OF WATER COMMISSIONERS  
 416 North State Street  
 Jackson, Mississippi 39201

**WATER WELL DRILLERS LOG**

JASPER  
E 16  
4-68  
US GEO SUR  
4/30 1968

C. P. Clark  
 firm name

Jasper  
 county well located

**LANDOWNER:**

Montrose

**description of formations encountered**

**from to**

Water Assoc.  
Montrose Miss.  
 (mailing address)

<u>Red Clay</u>	<u>0</u>	<u>18</u>
<u>fine sand</u>	<u>18</u>	<u>25</u>
<u>Grey Clay Hard</u>	<u>25</u>	<u>32</u>
<u>Blue Clay</u>	<u>32</u>	<u>223</u>
<u>Sand + Clay fine</u>	<u>223</u>	<u>279</u>
<u>fine sand</u>	<u>279</u>	<u>330</u>
<u>fine to med sand</u>	<u>330</u>	<u>370</u>
<u>Med. sand</u>	<u>370</u>	<u>398</u>
<u>Clay</u>	<u>398</u>	<u>463</u>
<u>Rocky Clay</u>	<u>463</u>	<u>497</u>
<u>Clay + Shells</u>	<u>497</u>	<u>531</u>
<u>Clay Sand streaks</u>	<u>531</u>	<u>556</u>
<u>Med sand</u>	<u>556</u>	<u>613</u>

**WELL LOCATION:**


sec. 1 T. 30 N. R. 10 E.  
 S. W.  
in Montrose  
 (distance) miles (direction) of (nearest town)

**WELL PURPOSE:**

(home, irrigation, municipal, industrial)

**WELL COMPLETION DATA:**

- (1) diameter (inches) 4 1/2
- (2) total depth (feet) 613
- (3) static water level (feet) 160 below top of ground.
- (4) casing iron (material) 463 (depth)
- 4 1/2 (size) or telescope see back.
- (5) screen 30ft (length) 488 (depth to top)
- 2 1/2 (size) # 304 S.S. (material)
- (6) pump 1 1/2 (HP) 80 (yield gpm)
- 3 Phase (type power) 220 V
- (7) electric log Yes (yes or no)
- U.S.G.S. (organization running log)
- (8) how well bottom plugged BW U

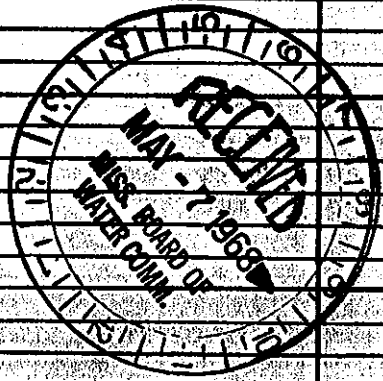

**DRILLERS REMARKS:**