

3 130 3203100 1890630 TEGCO

Jasper
G3
9-12-68

MISSISSIPPI CODED
BOARD OF WATER COMMISSIONERS
416 North State Street
Jackson, Mississippi 39201

WATER WELL DRILLERS LOG

9.12.1968 Royl West Jasper
date well completed firm name county well located


LANDOWNER: W.W. Doolittle
Rt 1 Laurin
Miss (mailing address)

description of formations encountered	from	to
Sandy Clay	0	25
Blue Clay	25	125
fine sand	125	135
gray clay	135	320
Sand	320	344

WELL LOCATION:
sec 30.3 N R 12 E
12 miles N.E. of Bay Springs
(distance) (direction) (nearest town)

WELL PURPOSE:
(home, irrigation, municipal, industrial)

- WELL COMPLETION DATA:
- (1) diameter (inches) 2
 - (2) total depth (feet) 344
 - (3) static water level (feet) 63 below above top of ground.
 - (4) casing galv (material), (depth)
 - (size) If telescope see back.
 - (5) screen 10ft 334 (length) (depth to top)
1 1/4 St Steel (size) (material)
 - (6) pump 1 6 (HP) (yield gpm)
Rea (type power)
 - (7) electric log No (yes or no)
 - (organization running log)
 - (8) how well bottom plugged Washed

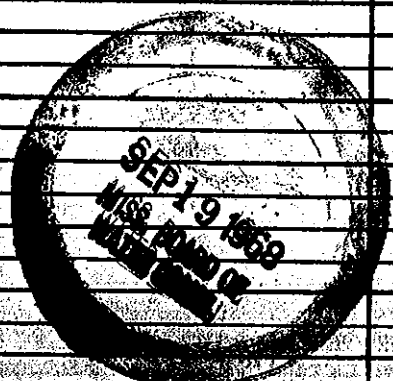

DRILLERS REMARKS: