		Cone	rly 28-14 #1
	State Well	Keport	For Office Use Only:
County: Jasper	Part 1		
Permit #:	Mississippi Department of I Office of Land and W		Aquifer:
Driller: GARY RAYBORN	P.O. Box 1		Well#: <u>635</u>
	Jackson, MS 39		L. S. Elevation:
Date drilling completed: <u>4-1-13</u>	(601)961-		
	(601)354-693	38 (fax)	E-log #:
State Law requires that this report 30 days of completion of drilling of		er in detail and filed v	with the Department within
Well Owner Informat	ion	22 Of We	Il Location Qa (1765911
FALFRGY DE	211 LiniG- Int	うん。06550	Il Location 0 N 89.07659 W "Longitude:"
Owner Name <u>ENERGY</u> DA		32-04-09	89-04 36
Mailing Address: <u>P. O. Box</u>	<u>705</u> Me		ne): Conventional Survey, 36
		-	d GPS, Survey-grade GPS
Natchez M City State	$\frac{5 39/21}{70000}$ N	E 14 SW 14 Sec 28	3 Twn <u>3N Rng 12E</u>
•		tance Direction	Nearest Town of <u>Gridley</u>
Telephone No. ( <u>601) 446 - 52</u>	<u>59</u> []	6 Miles NE	of <u>Gridley</u>
	Well Data		
Purpose of Well (circle one) Home Indu	stale 1 Datile Oscilla Ind	Tich Culture	Other Ric SUPPLY
-			
Date well drilling started: $4 - 1 - 13$	Date well o	Irilling completed:4	-1-13
If flowing, method of flow regulation: Valv	e Other (descri	he)	
Static Water Level: 160 feet abo	_		4-1-13
Method of Measurement (circle one) ste	el tape electric tape	air line other:	
Hole depth: <u>380</u> Well dep			
		/ell grouted to a depth of	<u> </u>
Type of grout (circle one): Cement		х. Х.	
Casing length: <u>340</u> feet Casing	g diameter: <u>4</u> inc	thes Type of casing:	PVC
Screen length: <u>40</u> feet Scree	n diameter: $A$ in	ches Type of screen:	PVC
	Setting depth: From		( ) ( ) ( ) ( ) ( ) ( ) ( ) ( ) ( ) ( )
			· · ·
Type of completion (circle all applicable): (	Gravel packed Underream	ed Telescoped Ope	n hole Natural Development
	Other (describe):	······	
Top of lap pipe or reduction in casing:	feet. If telesco	ped or more than one sc	reen, describe on back of page
Logs run (circle all applicable): No log run	Electrić Gamma Ray De	nsity Sonic Neutron	Other:
Name of organization running log(s):			
I certify that the well was drilled, constru	cted, and completed in accor	dance with all applicable	e requirements of the Mississippi
Department of Environmental Quality an	d/or the Mississippi Departm	ent of Health regulation	s and state laws.
RAYBORN DRILLING, INC.	0-60	7	-
			of Water Wel Con Refer CEIVE
Print Name of Water Well Contractor and I	icense No.	Signature	of water wat Conjecter CEIVE

.

۰.


BY: OLWP

If well telescopes please sketch below and show depths.



-	Description of Formations Encountered	From	To
	Yazoo Clay	0	180
	CHALK	180	275
	SILTY SAND	275	300
	Chalk	300	320
-	Fine Sand	326	335
	Medium SAND	335	380
-	······································		
e e e e e e e e e e e e e e e e e e e			
	······································		
	······································		
		1	

If more than one screen, show location of each on sketch

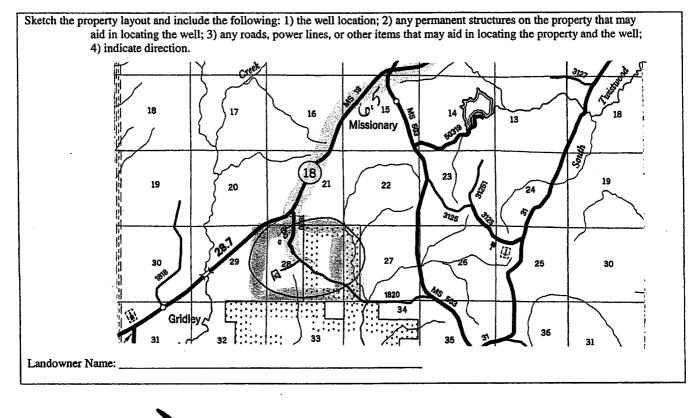

2-14-

Signature of Water Well Contractor

## APR 1 1 2013

BY: OLWR

County: JASPER Permit #: Mississippi Driller: Gary Rayborn Date completed: 4-1-13	Part 2 Department of Environmental Quality of Land and Water Resources P.O. Box 10631 Jackson, MS 39289-0631 (601)961-5210 (601)354-6938 (fax)	For Office Use Only:    Aquifer:    Well #:  635    Elevation:
This report should be prepared by the pump instal installation of pump.	_	
Well Owner Information Owner Name: <u>Energy Drilling, In</u> Mailing Address: <u>P.O.Box 905</u> <u>Natchez MS 3912</u> City State Zip Co Telephone No. ( <u>601</u> ) 446 - 5259	$\begin{array}{c} \underline{AC} \\ \underline{AC} \\$	Longitude: <u>89.64659</u> (04.36) ne): Conventional Survey, nd-held GPS, Survey-grade GPS <u>8</u> Twn <u>3N</u> Rng <u>12E</u> Nearest Town of <u>Gridley</u>
Ритр Туре	P(	ower Type
Circle one		Circle one
Air Lift Jet Submersible	Diesel Engine Gasoli	ine Engine Natural Gas
Bucket Piston Turbine	Electric Motor Hand	Tractor PTO
Centrifugal  Rotary  Flowing We    Other (specify):	Horse Power Rating of Moto Setting Depth:	<u>s</u> [feet
Pump Test Data		leasuring Water Level
Date Well Tested: $4 - 1 - 2013$ Static Water Level (A): $160$ Feet Below Land S Pumping Water Level (B):Feet Below Land S Drawdown [(B) - (A)]:Feet Below Land S	Air Line Electric Me Surface Other (specify):	shut in head:feet
Test Pumping Rate:  (o)  Gallons Per I    Duration of Pump Test (minimum 4 hours):		GPM with a drawdown ofhours of pumping
I HEREBY EEPTIFY that the above statements are true KAYBURN DRILLING, INC. O-C Print Name of Pump Installer and License No. (if applica		Installe RECEIV
Frint Name of Fully instance and License No. (If applica		APR 1 1 20
		BY: OLV

.

.

۰.