CHANGE OF OW	NERSHIP OF WELL!				
	ell Report 426-13 For Office Use Only:				
	t of Environmental Quality Aquifer:				
Permit #: Office of Land a	nd Water Resources				
I Deillar ICA FILL II IX IX IX IX IX II	Sox 10631 Well #: IS 39289-0631 L. S. Elevation:				
Date drilling completed: 41113 (601)	961-5210				
(601)354	4-6938 (fax) E-log #:				
State Law requires that this report be prepared by the driller in detail and filed with the Department within 30 days of completion of drilling of the well.					
New Well Owner Information Some Stringer	32.06550N 89.07659W Latitude:				
Mailing Address: 19 CR - 159	32 -0 3 -56 89 - 04 - 36 Method of Lat/Long (circle one): Conventional Survey,				
	USGS quad; (Hand-held GPS,) Survey-grade GPS				
Stringer, MS 39481 City State Zip Code	15 39481 SE 45W 14 Sec 28 Twn 3N Rng 12E				
Telephone No. (601) 425 - 2724	Tate ZIP Code Distance Distance Negreet Town				
Well 1	Data /				
Purpose of Well (circle one) (Home) Industrial Public Supply Irrigation Fish Culture Other: Date well drilling started: 4-1-2013 Date well drilling completed: 4-1-2013					
If flowing, method of flow regulation: Valve Other (d	lescribe)				
Static Water Level: 160 feet above of below (circle one) land surface Date measured: 4-1-2013					
Method of Measurement (circle one) steel tape electric tape air line other:					
Hole depth: 380' Well depth: 380'	Well grouted to a depth offeet				
Type of grout (circle one): Cement Bentonite Mix	er de la companya de				
Casing length: 340 feet Casing diameter: 4	inches Type of casing:PVC				
Screen length: 40 feet Screen diameter: 4	inches Type of screen: PVC				
Screen slot size: <u>o O 2 O</u> inches Setting depth: From _	340feet to <u>380feet</u>				
Type of completion (circle all applicable): Gravel packed Under	reamed Telescoped Open hole Natural Development				
Other (describe):					
Top of lap pipe or reduction in casing:feet. If to	elescoped or more than one screen, describe on back of page				
Logs run (circle all applicable) No log run Electric Gamma Ray	Density Sonic Neutron Other:				
Name of organization running log(s):	accordance with all applicable requirements of the Micsissippi				

Department of Environmental Quality and/or the Mississippi Department of Health regulations and state laws.

Print Name of Water Well Contractor and License No.

Signature of Water Well Contract CEIVED

APR 3 0 2013

Market State - 1 7 1 TO THE CONTROL OF THE DIVISORN DRILLING, ING.

Part 2 For Office Use Only: **Pump Installer's Completion Report** County: _ Mississippi Department of Environmental Quality Aquifer: Permit #: Office of Land and Water Resources P.O. Box 10631 C36 Well #: Jackson, MS 39289-0631 (601)961-5210 Date completed: Elevation: (601)354-6938 (fax) This report should be prepared by the pump installer in detail and filed with the Department within 30 days of the installation of pump. Well Owner Information Well Location Longitude: <u>89:07659W</u> Owner Name: Mailing Address: Method of Lat/Long (circle one): Conventional Survey, USGS quad, Hand-held GPS, Survey-grade GPS Twn 3N Rng 12E Distance Direction Nearest Town Telephone No. (601) 425 - 2724 Pump Type Power Type Circle one Circle one Diesel Engine Air Lift Jet Submersible Gasoline Engine Bucket Piston Turbine Electric Motor Hand Centrifugal Flowing Well Rotary Other (specify): Horse Power Rating of Mot Date Rump Installed: Setting Depth: Rated Pump Capacity: _ Gallons Per Minute Number of Stages:

Pump Test Data	Method of Measuring Water Level Circle one		
Date Well Tested:	,,,		
Static Water Level (A):Feet Below Land Surface	Air Line Electric Measuring Line Steel Tape Other (specify):		
Pumping Water Level (B):Feet Below Land Surface	Other (specify):		
Drawdown [(B) – (A)]:Feet Below Land Surface	For flowing well, measured shut in head:feet		
Test Pumping Rate:Gallons Per Minute	Well yieldedGPM with a drawdown of		
Duration of Pump Test (minimum 4 hours):hours	feet afterhours of pumping		

	I HEREBY CERTIFY that the above statements are true to the best of m	y knowledge.	
İ	Print Name of Pump Installer and License No. (if applicable)	Signature of Pump Installer	HEUEIVEL

APR 3 0 2013


If well telescopes please sketch below and show depths.

Ground Level

CHANGE SHIP OWNER WELL OF ONLY

Description of Formations Encountered	From	То
Vazoo Clay	0	180
CHALK	180	275
SILTY SAND	275	300
CHALK	300	320
FINE SAND	320	335
MEDIUM SAND	335	380

If more than one screen, show location of each on sketch

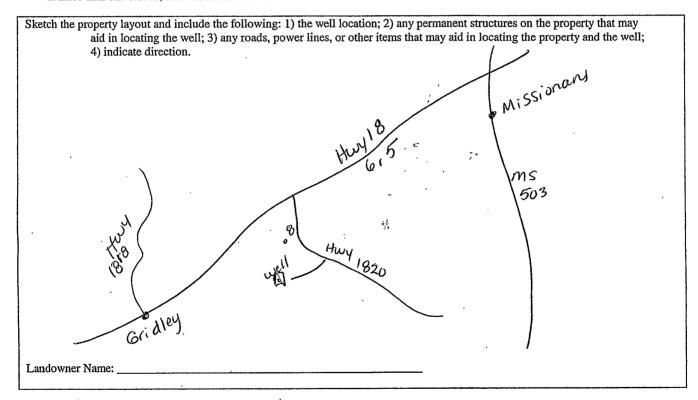

7

Signature of Water Well Contractor

RECEIVED

APR 3 0 2013

BY: OLWR

transferred ther					
transferred owner State Well Report Conerly 28-14 #1					
County: Jasper Part 1 For Office Use Only:					
Mississippi Department of Environmental Quality Aquifer:					
Permit #: Office of Land and Water Resources P.O. Box 10631 Well #:					
Jackson, MS 39289-0631					
Date drilling completed: 4-1-13 (601)961-5210					
(601)354-6938 (fax)					
State Law requires that this report be prepared by the driller in detail and filed with the Department within 30 days of completion of drilling of the well.					
Well Owner Information 32.06550N 89.07659W					
Owner Name LAILONG PRICE IN O HAILUIGE VERY LONGILLIGE					
Mailing Address: P. O. Box 905 Method of Lat/Long (circle one): Conventional Survey,					
USGS quad; Hand-held GPS, Survey-grade GPS					
City State Zip Code \\					
Telephone No. (601) 446-5259 Distance Direction Nearest Town I. 6 Miles NE of 6 rid leg					
\\\\\\\\\\\\\\\\\\\\\\\\\\\\\\\\\\\\\\					
Purpose of Well (circle one) Home Industrial Public Supply Irrigation Fish Culture Other: RIG SUPPLY					
Date well drilling started: 4-1-13/ Date well drilling completed: 4-1-13/					
If flowing, method of flow regulation: Valve Other (describe)					
Static Water Level: 160 feet above on below (circle one) land surface Date measured: 4-13					
Method of Measurement (circle one) steel tape (electric tape) air line sother:					
Hole depth: 380 Well depth: 380 Well grouted to a depth of 10					
Type of grout (circle one): Cement Bentonite Mix					
Casing length: 340 feet Casing diameter 4 inches Type of casing PVC					
Screen length: 40 feet Screen diameter 4 inches Type of screen: PVC					
Screen slot size: 10020 inches Setting depth: From 340 feet to 380 feet					
Type of completion (circle all applicable): Gravel packed Underreamed Telescoped Open hole Natural Development					
Other (describe):					
Top of lap pipe or reduction in casing:feet. If telescoped or more than one screen, describe on back of page					
Logs run (circle all applicabled: No log run Electric Gamma Ray Density Sonic Neutron Other:					
Name of organization running log(s): I certify that the well was drilled, constructed, and completed in accordance with all applicable requirements of the Mississippi					
Department of Environmental Quality and/or the Mississippi Department of Health regulations and state laws.					
RAYBORN DRILLING, INC. O-60					
Diani Circumstanti Control Villa Control Vil					

APR 3 0 2013