

STATE WELL REPORT

Part I

Driller's Log

Mississippi Department of Environmental Quality
 Office of Land and Water Resources
 P.O. Box 2309
 Jackson, MS 39225-2309
 (601)961-5210
 (601)360-0535 (fax)

For Office Use Only:

Well #: G38
 Aquifer: _____
 E-Log #: _____

County: Jasper
 Permit #: _____
 Driller: David West
 Date drilling completed: 7-31-2017

State Law requires that this report be prepared by the license holder responsible for the work and filed with the Department at the above address within 30 days of completion of drilling of the well or borehole.

Well Owner Information <small>(Landowner if borehole is not for a water well)</small>	Well or Borehole Location
Owner Name: <u>James Magee</u>	Latitude: <u>32-04-47</u> Longitude: <u>89-01-22</u>
Mailing Address: <u>261 CR 3126</u>	Method of Lat/Long (check one): Conventional Survey _____
<u>Rose Hill</u> <u>MS</u> <u>39356</u>	USGS quad <u>X</u> , Hand-held GPS _____, Survey-grade GPS _____
City State Zip Code	<u>SW</u> $\frac{1}{4}$ <u>SE</u> $\frac{1}{4}$, Sec <u>24</u> T <u>3N</u> R <u>10W</u>
Telephone No. <u>(601) 927-2239</u>	<u>3</u> Miles <u>NE</u> of <u>Paulding</u> <u>12E</u>
	(Distance) (Direction) (Nearest Town)

loc. questionable

Well / Borehole Data

Date drilling started: 7-30-17 Date drilling completed: 7-31-17 Hole depth: 300' Hole diameter: 6 1/2"

Location of the source of any surface water used for drilling: well water

Method of dosing and volume of Chlorine used in drilling and development: Tabs 50ppm

Logs run (circle all applicable): (No log run) Electric Gamma Ray Density Sonic Neutron Other: _____

Name of organization running log(s): _____

Purpose of borehole (circle one): (Water Well) Geotechnical/Geological Investigation Ground Source Heat Pump Seismic Survey Other (describe) _____

If drilling is not related to water well construction, skip the remainder of this block

Purpose of Well (circle all applicable): (Home) Industrial Public Supply Irrigation Fish Culture

Other (describe): _____

If a flowing well, method of flow regulation: Valve _____ Other (describe) _____

Static Water Level: 216 feet [above or (below) land surface Date measured: 7-30-2017
(circle one)

Method of measurement (circle one): Steel tape Electric tape Air line Other (describe): Sonar

Well depth: 20 Well grouted to a depth of: 20 feet Type of grout (circle one): Neat Cement Bentonite (Mix)

Casing length: 280 feet Casing diameter: 4 inches Type of casing: Pvc

Screen length: 20 feet Screen diameter: 4 inches Type of screen: Pvc

Screen slot size: .008 inches Setting depth: From 280 feet to 300 feet

Type of completion (circle all applicable): (Gravel packed) Underreamed Open hole Natural Development

Other (describe): _____

Top of lap pipe or reduction in casing: _____ feet


If telescoped or more than one screen, describe on next page

County: Sasfer
 Permit #: _____

For Office Use Only:
 Well #: 638

The sketch below only required for water wells


If well telescopes, show depths on sketch.

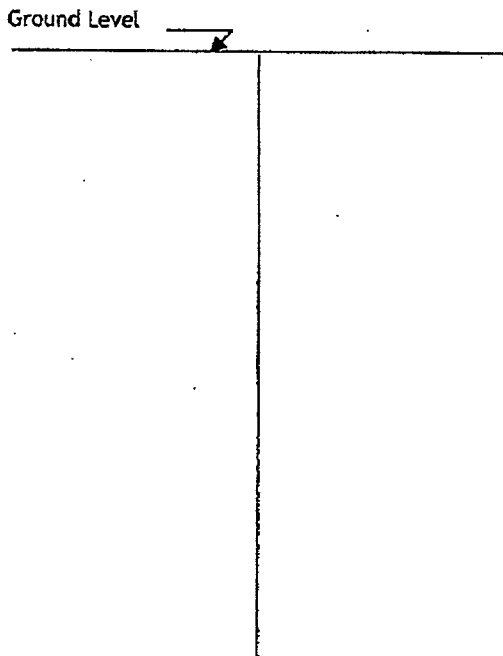

Description of formations encountered must be provided for all wells and boreholes, unless specifically exempted by regulations

Description of Formations Encountered	From (depth)	To (depth)
Sand	Ground level	24
Clay	24	220
Clay w/loam	220	236
Muddy's	236	248
Sand	248	300

If more than one screen, show location of each on sketch

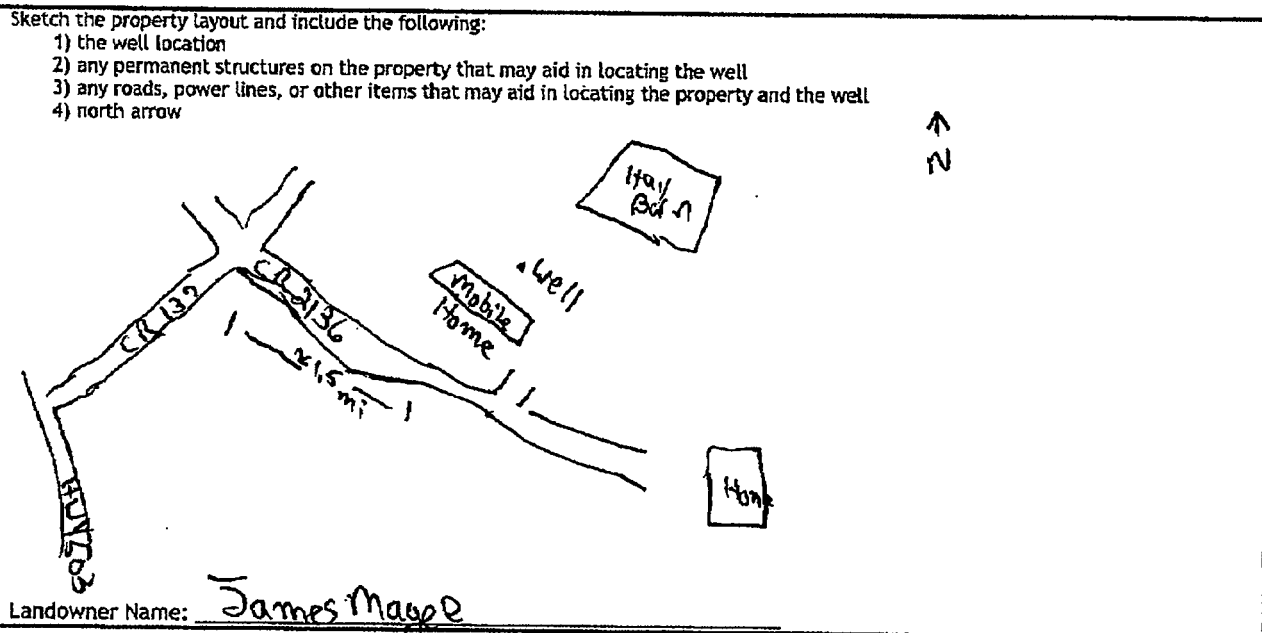

I HEREBY CERTIFY that the well/borehole was drilled, constructed, and completed in accordance with all applicable requirements of the Mississippi Department of Environmental Quality and the Mississippi Department of Health regulations, if applicable, and state laws.

David West 0692 8-1-2017 David West
 Print Name of Responsible Licensee and License No. Date Signature of Licensee

STATE WELL REPORT

Part 2

Pump Installer's Completion Report

Mississippi Department of Environmental Quality
 Office of Land and Water Resources
 P.O. Box 2309
 Jackson, MS 39225-2309
 (601)961-5210
 (601) 360-0535 (fax)

For Office Use Only:

Well #: G38
 Aquifer: _____

County: Sage
 Permit #: _____
 Driller: David West
 Date completed: 7-31-2017
Copy information from block on Part 1

This part of the report must be completed by a licensed water well contractor or a licensed pump installer. A copy of Part 1 of the report must be attached and both parts filed with the Department at the above address within 30 days of well completion.

Well Owner Information			Well Location		
Owner Name: <u>James Magee</u>	Latitude: <u>32-04-47</u>		Longitude: <u>89-01-22</u>		
Mailing Address: <u>261 CR 3126</u>	Method of Lat/Long (check one): Conventional Survey _____				
<u>Rose Hill</u> MS <u>39356</u>	USGS quad <u>A</u> , Hand-held GPS _____, Survey-grade GPS _____				
City State Zip Code	<u>SW 1/4 SE 1/4, Sec 24 T 3N R 10W</u>				
Telephone No. <u>(601) 729-2239</u>	<u>3</u> Miles <u>NE</u> of <u>Rawlins</u>		<u>12E</u>		
	(Distance)		(Direction)		(Nearest Town)

Pump Type (check one)

Submersible Turbine Air Lift Centrifugal Flowing Well Jet Piston Rotary Other (describe): _____

Date Pump Installed: 7-31-2017 Rated Pump Capacity: 10 Gallons Per Minute

Is This Pump (check one): New Repaired Replacement

Power Type (check one)

Electric Diesel Gasoline Natural Gas Tractor PTO Windmill Other (describe): _____

Horse Power Rating of Motor: 1 H.P. Setting Depth: 260 feet Number of Stages: _____

Pump Test Data for Non Flowing Well

Date Well Tested: _____ Duration of Pump Test (minimum 4 hours): _____ hours

Static Water Level (A): _____ Feet Below Land Surface Pumping Water Level (B): _____ Feet Below Land Surface

Drawdown [(B) - (A)]: _____ Feet Below Land Surface Test Pumping Rate: _____ Gallons Per Minute

Method of measurement (check one): Steel tape Electric tape Air line Other (describe): _____

Pump Test Data for Flowing Well

Measured shut in head: _____ feet.

Well yielded _____ GPM with a drawdown of _____ feet after _____ hours of pumping

Meter Installation

Meter Manufacturer: _____ Meter Serial Number: _____

Meter Model Number/Name: _____ Type of Meter: _____

Totalizer Register Unit and Multiplier Factor (AF x .001, gal x 1000, etc): _____

Installation Date: _____ Meter installed by: _____

Is This Meter (check one): New Repaired Replacement

Important: By submitting the above information you are certifying that this meter was installed to manufacturer standards. For agricultural wells, a list of approved meters is on the MDEQ website.

I HEREBY CERTIFY that the above statements are true to the best of my knowledge.

David West 0672 8-1-2017 David West
 Print Name of Pump Installer and License No. (if applicable) Date Signature of Pump Installer