

JASPER MISSISSIPPI BOARD OF WATER COMMISSIONERS

2 H 27  
11-64

WATER WELL DRILLERS LOG *Sheet 2*

Date: Nov., 1964, Driller: Deepa Drilling Co. County JASPER  
(Name)


(1) Owner of Land: BAKER  
(Name)  
  
(Address)  
  
(2) Location: 1/4, 1/4, Sec. 24 3N 13E T R  
5 miles NW of PACHOTA  
(distance) (direction) (Nearest Town)  
  
(3) Topography: Hilly  
(Hilly) (Flat) (Level)  
  
(4) Purpose of Well: Home  
(Domestic Irrigation  
Municipal, Industrial, Other)

Description & Color of Materials Sand, Clay, Red Clay, Shell, etc.	Thick- ness Feet	Depth Feet
<u>Yellow Sand &amp; clay</u>	<u>10</u>	<u>10</u>
<u>Yellow Sand</u>	<u>25</u>	<u>35</u>
<u>Blue mud</u>	<u>28</u>	<u>63</u>
<u>Green fine limestone</u>	<u>83</u>	<u>146</u>
<u>White sand</u>	<u>32</u>	<u>178</u>

Information upon completion of well:

- (1) Diameter 2 inches.
- (2) Total Depth 178 feet.
- (3) Water Level 43 feet below top of ground.
- (4) Cased to 172', Size 2"
- (5) Screen: Size 2", Length 6'
- (6) Were any formations sealed against pollution?  
\_\_\_\_\_ yes, \_\_\_\_\_ no.

If YES depth of formation \_\_\_\_\_  
Why \_\_\_\_\_  
Drillers Remarks: \_\_\_\_\_

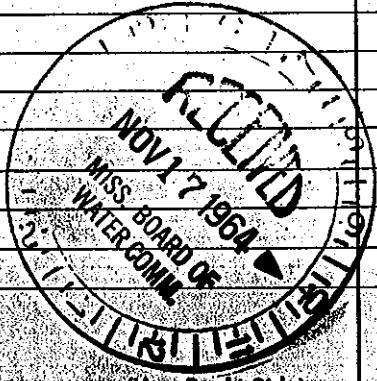

(Use Back Side)

Well No.

Mail this copy to Board of Water Commissioners 429 Miss. St. Jackson, Miss.