

JASPER MISSISSIPPI BOARD OF WATER COMMISSIONERS

H3

WATER WELL DRILLERS LOG 3

6-65


Date: June, 1965, Driller: Peeples Drilling County, Jasper
(Name)

(1) Owner of Land:	Description & Color of Materials Sand, Clay, Red Clay, Shell, etc.	Thick- ness Feet	Depth Feet
<u>Viola Crosby</u> <small>(Name)</small>	<u>Red sand & sandy clay</u>	<u>15</u>	<u>15</u>
<u>Rt 1 Pachuta, Miss.</u> <small>(Address)</small>	<u>Blue clay</u>	<u>27</u>	<u>42</u>
(2) Location: <u>1/4</u> , <u>1/4</u> , Sec. <u>25</u> <u>3N</u> <u>13E</u>	<u>light & lime rock</u>	<u>63</u>	<u>105</u>
<u>4</u> miles <u>NW</u> , of <u>Pachuta</u> , <small>(distance) (direction) (Nearest Town)</small>	<u>white sand & black</u>	77	182
(3) Topography: <u>Hilly</u> <small>(Hilly) (Flat) (Level)</small>	<u>lignite streak</u>	<u>77</u>	<u>182</u>
(4) Purpose of Well: <u>Home</u> <small>(Domestic Irrigation Municipal, Industrial, Other)</small>			

Information upon completion of well:

- (1) Diameter 2 inches.
- (2) Total Depth 186 feet.
- (3) Water Level 35 feet below top of ground.
- (4) Cased to 182', Size 2"
- (5) Screen: Size 2", Length 6'
- (6) Were any formations sealed against pollution?
 yes, no.

If YES depth of formation _____
 Why _____
 Drillers Remarks: _____

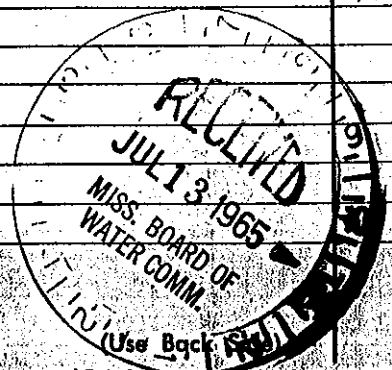

Well No. _____

Mail this copy to Board of Water Commissioners 429 Miss. St. Jackson, Miss.