

JASPER

MISSISSIPPI BOARD OF WATER COMMISSIONERS

WATER WELL DRILLERS LOG

Date: 2-22-62, 1962, Driller: Layne-Central Co. County Jasper

(1) Owner of Land: City of Bay Springs
Bay Springs, Mississippi

(2) Location: 1/4 NW 1/4, Sec 33, R10, S10
miles of (distance) (direction) (Nearest Town)

(3) Topography: (Hilly) (Flat) (Level)

(4) Purpose of Well: Municipal
(Domestic Irrigation Municipal, Industrial, Other)

Table with 3 columns: Description & Color of Materials, Thickness Feet, Depth Feet. Rows include red clay, shale, soft clay, fine sand, clay, sand, gumbo, sandy shale, hard shale, sandy shale, sand, shale, fine sand, med. sand, shale.


Information upon completion of well:

- (1) Diameter 10 inches.
(2) Total Depth 642 feet.
(3) Water Level 112 feet below top of ground.
(4) Cased to 580 feet, Size
(5) Screen: Size 6 inches, Length 50 feet
(6) Were any formations sealed against pollution?
yes, no.

If YES depth of formation 580 feet

Why required

Drillers Remarks:

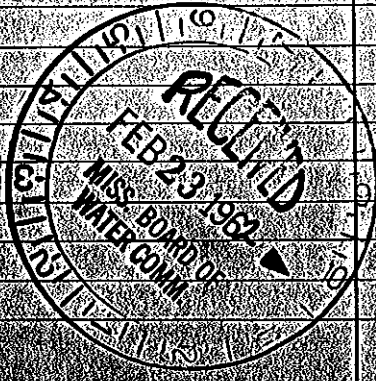

(Use Back Side)

Well No.