

MISSISSIPPI BOARD OF WATER COMMISSIONERS

WATER WELL DRILLERS LOG

CODED

Date: 9-25- 1966, Driller: Layne-Central Co. County Jasper

(Name)

(1) Owner of Land: City of Bay Springs
 (Name)
Bay Springs, Mississippi
 (Address) 29

(2) Location: 1/4, 1/4, Sec. 23 T 2 R 10
29 miles 29 of 29
 (distance) (direction) (Nearest Town)

(3) Topography: _____
 (Hilly) (Flat) (Level)

(4) Purpose of Well: municipal
 (Domestic Irrigation
 Municipal, Industrial, Other)

Description & Color of Materials Sand, Clay, Red Clay, Shell, etc.	Thick- ness Feet	Depth Feet
soil	2	2
sandy clay	6	8
clay	17	25
soft sandy yellow clay	27	52
black clay	23	75
rock	1	76
clay stks of hard lime	13	89
black sand	32	121
clay	41	162
sandy clay	43	205
clay (Yazoo)	319	524
rock	2	526
sandy shale-stks brittle		
lime	63	589
fine sand	69	658
sand & shale	26	684
shale	84	768
rock	1	769
shale-rock breaks	9	778
rock	1	779
hard shale-rock bks.	7	786
rock	1	787
hard shale	6	793
rock	2	795
shale	2	797
rock	1	798
shale	5	803
rock	1	804
shale	3	807
rock	7	808
shale		815
shale-rock breaks	4	819

CODED

Information upon completion of well:

(1) Diameter 12 inches.

(2) Total Depth 1008 feet.

(3) Water Level 175 feet below top of ground.

(4) Cased to 917', Size 12"

(5) Screen: Size 8", Length 80'


(6) Were any formations sealed against pollution?
X yes, _____ no.

If YES depth of formation 917'

Why _____ required

Drillers Remarks: _____

Continued on back

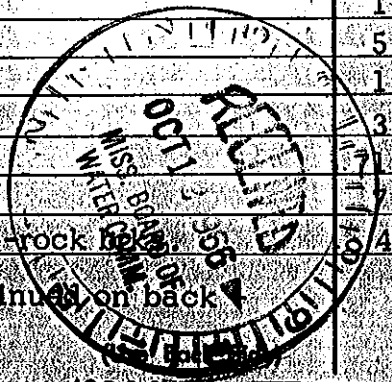

Well No