

JASPER

J 14

MISSISSIPPI BOARD OF WATER COMMISSIONERS

5-2-66


WATER WELL DRILLERS LOG

Date: 5-2, 1966, Driller: LEACH County: Jasper

1) Owner of Land: Thelmer Peyton
2) Location: SW 1/4, SW 1/4, Sec 30 T2 R10, 2 miles West of Bay Springs
3) Topography: [checked] (Level)
4) Purpose of Well: [checked] (Domestic Irrigation)

Table with 4 columns: Description & Color of Materials, Thickness Feet, Depth Feet. Rows include Red clay, Sand, Rock, Blue clay, Shell, Rocky sand, Sand.

Information upon completion of well:
1) Diameter: 2 inches.
2) Total Depth: 225 feet.
3) Water Level: 160 feet below top of ground.
4) Cased to: 215, Size: 2"
5) Screen: Size: 2", Length: 10'
5) Were any formations sealed against pollution?
YES depth of formation
Drillers Remarks:
Yield in gpm: 10
Size pump: 2 HP air
Type power:

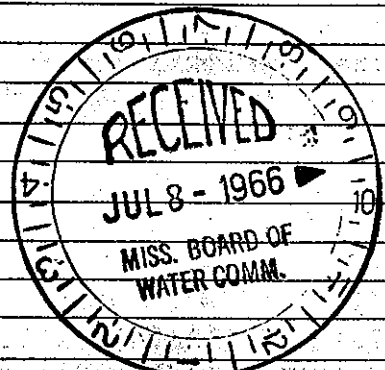

Total 225

Mail this copy to Board of Water Commissioners 429 Miss. St. Jackson, Miss.