

MISSISSIPPI BOARD OF WATER COMMISSIONERS

3-7-5-66

WATER WELL DRILLERS LOG 79.0


Date: 7-5, 1964, Driller: LEACH County Jasper
 (When well drilled) (Name) (Where well is located)

(1) Owner of Land	Description & Color of Materials Sand, Clay, Red Clay, Shell, etc.	Thick- ness Feet	Depth Feet
<u>Frank JAMES</u> (Name) <u>Bay Springs MISS</u> (Address)	<u>Sandy clay</u>	<u>35</u>	<u>35</u>
(2) Location: <u>NW 1/4, SW 1/4, Sec 31, T21R10E</u>	<u>Sand</u>	<u>20</u>	<u>55</u>
<u>4</u> miles <u>West</u> , of <u>Bay Springs</u> (distance) (direction) (Nearest Town)	<u>Rock</u>	<u>30</u>	<u>85</u>
(3) Topography: <input checked="" type="checkbox"/> (Hilly) <input type="checkbox"/> (Flat) <input type="checkbox"/> (Level)	<u>Blue clay</u>	<u>25</u>	<u>110</u>
(4) Purpose of Well: <u>Res. Purifier</u> (Domestic Irrigation, Municipal, Industrial, Other)	<u>Rock & Shell</u>	<u>30</u>	<u>140</u>
	<u>Sand</u>	<u>35</u>	<u>175</u>
	<u>Sand</u>	<u>70</u>	<u>242</u>

Information upon completion of well:

- (1) Diameter 4 1/2 inches.
- (2) Total Depth 242 feet.
- (3) Water Level 120 feet below top of ground.
- (4) Cased to 189, Size 4", 30, 2".
- (5) Screen: Size 2 1/2 Length 20'.
- (6) Were any formations sealed against pollution?
yes, no.

1/2 mile 531
It going to be 531
1st bit run to right
80.1

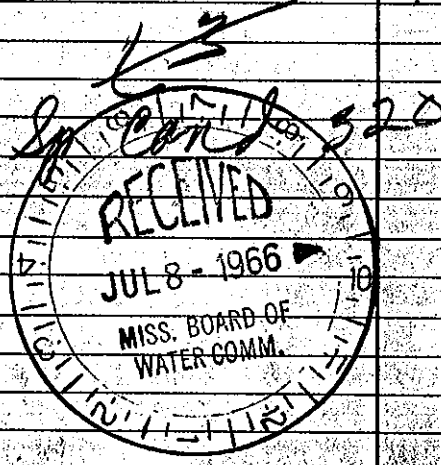

If YES depth of formation _____
 Why Clear
 Driller's Remarks: Can't measure
 Yield in gpm: 30
 Size pump: 1 1/2 HP Sub.
 Type power: _____

Total 242