

JASPER MISSISSIPPI BOARD OF WATER COMMISSIONERS

6X J19

3-12-66 WATER WELL DRILLERS LOG

Date: 3-12, 1966, Driller: Brown Brother County Jasper
(Name)

(1) Owner of Land: <u>Willie Reese</u> (Name)	Description & Color of Materials Sand, Clay, Red Clay, Shell, etc.	Thick- ness Feet	Depth Feet
<u>Bay Springs</u> (Address)	<u>Clay Lime</u>	<u>0</u>	<u>20</u>
(2) Location: <u>M 1/4, E 1/4, Sec. 7</u> ^{<u>2N 10E</u>} <u>T R</u>	<u>Shale</u>	<u>20</u>	<u>40</u>
_____ miles _____ of _____ (distance) (direction) (Nearest Town)	<u>Shale</u>	<u>40</u>	<u>60</u>
(3) Topography: <u>Hilly</u> (Hilly) (Flat) (Level)	<u>Shale</u>	<u>60</u>	<u>80</u>
(4) Purpose of Well: <u>Home</u> (Domestic Irrigation Municipal, Industrial, Other)	<u>Shale</u>	<u>80</u>	<u>100</u>
	<u>good sand at 94 ft</u>	<u>100</u>	<u>10</u>
	<u>To 111 ft</u>		

Information upon completion of well:

(1) Diameter 4 1/4 inches.

(2) Total Depth 110 feet.

(3) Water Level 60 feet below top of ground.

(4) Cased to 105, Size 2


(5) Screen: Size 2, Length 5 ft

(6) Were any formations sealed against pollution?
_____ yes, no no.

If YES depth of formation _____

Why _____

Drillers Remarks: _____

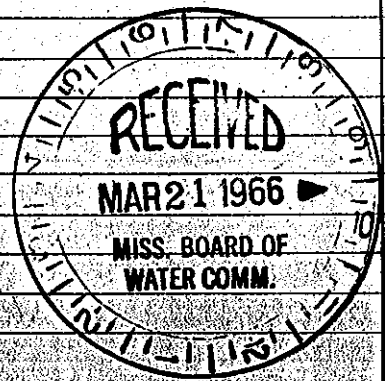

Well No. 02

(Use Back Side)