

well # 2

State Well Report

Part 1

Mississippi Department of Environmental Quality
Office of Land and Water Resources
P.O. Box 10631
Jackson, MS 39289-0631
(601)961-5210
(601)354-6938 (fax)

For Office Use Only:

Aquifer: _____
Well #: J-44
L. S. Elevation: _____
E-log #: _____

County: Jasper
Permit #: _____
Driller: Roy West Dally
Date drilling completed: 10-31-05

State Law requires that this report be prepared by the driller in detail and filed with the Department within 30 days of completion of drilling of the well.

Well Owner Information	Well Location
Owner Name: <u>Timber Plus Inc</u>	Latitude: <u>32° 01' 05"</u> Longitude: <u>89° 14' 47"</u>
Mailing Address: <u>P.O. Box 1188</u>	Method of Lat/Long (circle one): <u>DOT MAP</u> USGS quad, Hand-held GPS, Survey-grade GPS
<u>Stringer MS 39481</u> City State Zip Code	<u>NE 1/4 SW 1/4 Sec 16 Twn 2N Rng 10E</u>
Telephone No. <u>(001) 425-9505</u>	Distance <u>2</u> Miles <u>N</u> Direction of <u>Bay Springs</u> Nearest Town

Well Data

Purpose of Well (circle one) Home Industrial Public Supply Irrigation Fish Culture Other: Woodyard

Date well drilling started: 10-31-05 Date well drilling completed: 10-31-05

If flowing, method of flow regulation: Valve _____ Other (describe) _____

Static Water Level: 54 feet above or below (circle one) land surface Date measured: 10-31-05

Method of Measurement (circle one) steel tape electric tape air line other: _____

Hole depth: 108 Well depth: 108 Well grouted to a depth of 10 feet

Type of grout (circle one): Cement Bentonite Mix

Casing length: 88 feet Casing diameter: 4 inches Type of casing: PVC

Screen length: 20 feet Screen diameter: 4 inches Type of screen: PVC slotted

Screen slot size: .008 inches Setting depth: From 88 feet to 108 feet

Type of completion (circle all applicable): Gravel packed Underreamed Telescoped Open hole Natural Development

Other (describe): _____

Top of lap pipe or reduction in casing: _____ feet. If telescoped or more than one screen, describe on back of page

Logs run (circle all applicable): No log run Electric Gamma Ray Density Sonic Neutron Other: _____

Name of organization running log(s): _____


I certify that the well was drilled, constructed, and completed in accordance with all applicable requirements of the Mississippi Department of Environmental Quality and/or the Mississippi Department of Health regulations and state laws.

David A. West 0672 _____
Print Name of Water Well Contractor and License No. Signature of Water Well Contractor

RECEIVED
NOV 18 2005
BY: OLWR

well #2
If well telescopes please sketch below and show depths.

J-44

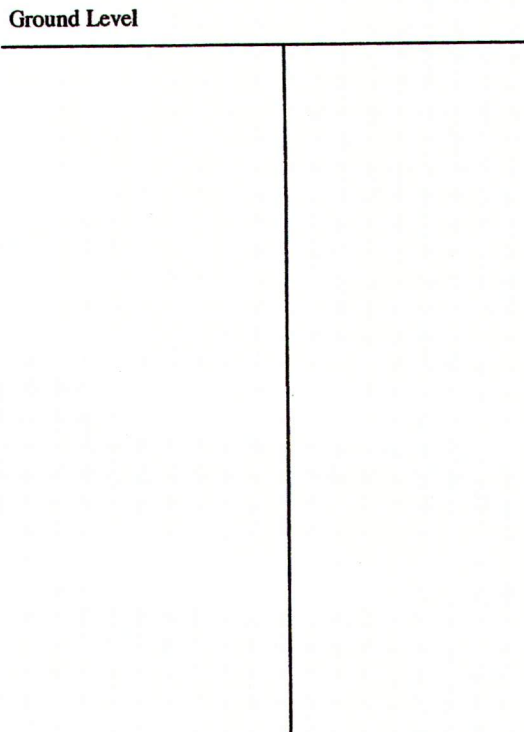

Description of Formations Encountered	From	To
CLAY	0	5
SAND	5	74
CLAY	74	76
SAND	76	108

If more than one screen, show location of each on sketch

Sketch the property layout and include the following: 1) the well location; 2) any permanent structures on the property that may aid in locating the well; 3) any roads, power lines, or other items that may aid in locating the property and the well; 4) indicate direction.

Landowner Name: Timber Plus Inc

David A. Wilson
Signature of Water Well Contractor

RECEIVED
NOV 18 2005
BY: OLWR

well #2

STATE WELL REPORT

Part 2

Pump Installer's Completion Report
Mississippi Department of Environmental Quality
Office of Land and Water Resources
P.O. Box 10631
Jackson, MS 39289-0631
(601)961-5210
(601)354-6938 (fax)

For Office Use Only:

Aquifer: _____

Well #: J-44

Elevation: _____

County: Jasper

Permit #: _____

Driller: Roy V. West Drilling

Date completed: 10-31-05

This report should be prepared by the pump installer in detail and filed with the Department within 30 days of the installation of pump.

Well Owner Information	Well Location
Owner Name: <u>Timber Plus Inc</u>	Latitude: <u>32° 01'</u> Longitude: <u>89° 14'</u>
Mailing Address: <u>P.O. Box 1188</u>	Method of Lat/Long (circle one): Conventional Survey, <u>DOT MAP</u> USGS quad, Hand-held GPS, Survey-grade GPS
<u>Stinger MS 39481</u> City State Zip Code	<u>NE ¼ SW ¼ Sec 16 Twn 2N Rng 10E</u>
Telephone No. <u>(601) 425-9505</u>	Distance Direction Nearest Town <u>½</u> Miles <u>N</u> of <u>Bay Springs</u>

Pump Type Circle one	Power Type Circle one
Air Lift Jet <u>Submersible</u>	Diesel Engine Gasoline Engine Natural Gas
Bucket Piston Turbine	<u>Electric Motor</u> Hand Tractor PTO
Centrifugal Rotary Flowing Well	Windmill Other (specify): _____
Other (specify): _____	Horse Power Rating of Motor: <u>2</u>
Date Pump Installed: <u>11-4-05</u>	Setting Depth: <u>80</u> feet
Rated Pump Capacity: <u>30</u> Gallons Per Minute	Number of Stages: _____

Pump Test Data	Method of Measuring Water Level Circle one
Date Well Tested: _____	Air Line Electric Measuring Line Steel Tape
Static Water Level (A): _____ Feet Below Land Surface	Other (specify): _____
Pumping Water Level (B): _____ Feet Below Land Surface	For flowing well, measured shut in head: _____ feet
Drawdown [(B) - (A)]: _____ Feet Below Land Surface	Well yielded _____ GPM with a drawdown of _____ feet after _____ hours of pumping
Test Pumping Rate: _____ Gallons Per Minute	
Duration of Pump Test (minimum 4 hours): _____ hours	

I HEREBY CERTIFY that the above statements are true to the best of my knowledge.

David A. West 0672
Print Name of Pump Installer and License No. (if applicable)

David A. West
Signature of Pump Installer

RECEIVED
NOV 18 2005
BY: OLWR