

5 JASPER  
K3

WATER WELL DRILLERS LOG 3

Date: 12-27-65, 1965, Driller: Brown Brothers County Jasper  
(Name)

(1) Owner of Land: William H. Jordan  
(Name)  
Lowin Miss  
(Address)

(2) Location: 1/4, 1/4, Sec. 14 T2 R11E  
8 EAST of BOYSDEN  
(distance) (direction) (Nearest Town)

(3) Topography: Hilly  
(Hilly) (Flat) (Level)

(4) Purpose of Well: House  
(Domestic Irrigation  
Municipal, Industrial, Other)

Description & Color of Materials Sand, Clay, Red Clay, Shell, etc.	Thick- ness Feet	Depth Feet
CLAY Sand	0	20
Blue SH 21R	20	40
[Hand-drawn wavy lines representing soil layers]	40	60
	60	80
	80	100
	140	20
	20	40
	40	60
	60	80
	80	200
	200	20
	20	40
40	60	
60	80	
Gray Shale	80	200
" "	300	20
" "	20	40
SAND AT 355	40	60
" "	60	70

Information upon completion of well:

(1) Diameter \_\_\_\_\_ inches.

(2) Total Depth 370 feet.

(3) Water Level 70 feet below top of ground.

(4) Cased to 360, Size 2 in


(5) Screen: Size 10 FT 2 in Length 10

(6) Were any formations sealed against pollution?  
\_\_\_\_\_ yes, no no.

If YES depth of formation \_\_\_\_\_

Why \_\_\_\_\_

Drillers Remarks: Good well

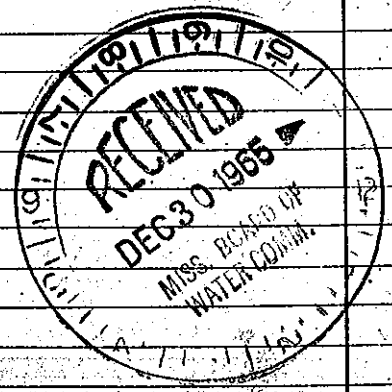

Well No. 10

(Use Back Side)