

JASPER MISSISSIPPI BOARD OF WATER COMMISSIONERS

K4


7-17-65

WATER WELL DRILLERS LOG

Date: 7-17, 1965, Driller: ^{Brown} ~~Ray~~ Brothers County Jasper
(Name)

(1) Owner of Land: Glen McNeil
(Name)
RAY Springs
(Address)
(2) Location: 1/4, 1/4, Sec. 9 T2R11,
6 miles East of RAY Springs
(distance) (direction) (Nearest Town)
(3) Topography: Hilly
(Hilly) (Flat) (Level)
(4) Purpose of Well: For Home
(Domestic Irrigation
Municipal, Industrial, Other)

Description & Color of Materials Sand, Clay, Red Clay, Shell, etc.	Thick- ness Feet	Depth Feet
CLAY	0	20
Green shale	20	40
	10	60
	20	80
	80	100
	100	20
	20	40
	40	60
	60	80
	80	200
	200	20
lime AT 225	20	40
gray shale	40	60
	60	80
light	80	300
Sand AT 308	300	20
"	20	40
"	40	60
"	60	372
T D 372		

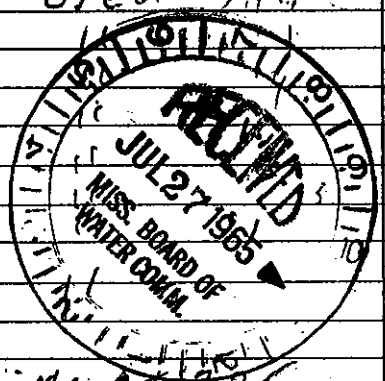

Information upon completion of well:

(1) Diameter 4 1/2 inches.
(2) Total Depth 372 feet.
(3) Water Level 65 feet below top of ground.
(4) Cased to 362, Size 10 1/2.
(5) Screen: Size 2, Length 10 FT.
(6) Were any formations sealed against pollution?
yes, no no.

If YES depth of formation _____
Why _____
Drillers Remarks: _____

(Use Back Side)

Well No.