

6 JASPER

L 2 MISSISSIPPI BOARD OF WATER COMMISSIONERS

5-24-66

WATER WELL DRILLERS LOG

Date: 5-24, 19, Driller: LEACH County Jasper  
(When well drilled) (Name) (Where well is located)

1) Owner of Land	Description & Color of Materials	Thick-ness Feet	Depth Feet
Sanderford medlin (Name)	Sand, Clay, Red Clay, Shell, etc.		
Day Springs Miss. (Address)	Red clay sand	20	20
	yellow clay	65	115
2) Location: 1/4, 1/4, Sec. 31 2N 12E T. R.	Red clay	300	415
10 miles East of Day Springs (distance) (direction) (Nearest Town)	Shell	20	440
3) Topography: <input checked="" type="checkbox"/> (Hilly) <input type="checkbox"/> (Flat) <input type="checkbox"/> (Level)	Sand & clay (mix)	60	505
4) Purpose of Well: <input checked="" type="checkbox"/> (Domestic Irrigation) <input type="checkbox"/> (Municipal, Industrial, Other)	Sand	15	520

Information upon completion of well:

1) Diameter 2 inches.


2) Total Depth 520 feet.

3) Water Level 70 feet below top of ground.

4) Cased to 510, Size 2"

5) Screen: Size 2 1/2", Length 10

6) Were any formations sealed against pollution?  
yes,  no.

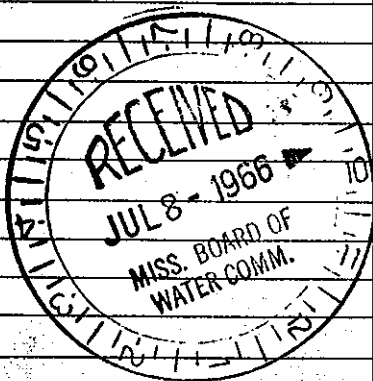

YES depth of formation \_\_\_\_\_

Why \_\_\_\_\_

Drillers Remarks: \_\_\_\_\_

Yield in gpm: 20

Size pump: 3 HP air compressor

Type power: electric

Total 520

Mail this copy to Board of Water Commissioners 429 Miss. St. Jackson, Miss.